

---	--------------------------------------	--------------------------	-------------------------------	----------------------------


Distance and direction from nearest town or city, street address of well if located within city?
6063 N Edwards Valley Cir in KS.

2 WATER WELL OWNER: Dean Valentine

RR#, St. Address, Box # : 5811 N. Legion
City, State, ZIP Code : Wichita KS 67204 50

3 LOCATE WELL'S LOCATION WITH AN "X" IN SECTION BOX: 4 DEPTH OF COMPLETED WELL. 500 ft. ELEVATION:

Depth(s) Groundwater Encountered 1. 18 ft. 2. ft. 3. ft.

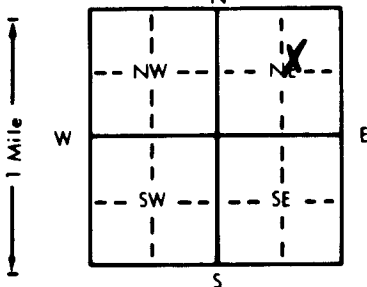

WELL'S STATIC WATER LEVEL 18 ft. below land surface measured on mo/day/yr

Pump test data: Well water was 18 ft. after 1 1/2 hours pumping 20 gpm

Est. Yield gpm: Well water was _____ ft. after _____ hours pumping _____ gpm

Bore Hole Diameter _____ in. to _____ ft., and _____ in. to _____ ft.

WELL WATER TO BE USED AS:

<u>1</u> Domestic	3 Feedlot	6 Oil field water supply	9 Dewatering	11 Injection well
2 Irrigation	4 Industrial	7 Lawn and garden only	10 Monitoring well	12 Other (Specify below)

Was a chemical/bacteriological sample submitted to Department? Yes _____ No X; If yes, mo/day/yr sample was submitted _____

Water Well Disinfected? Yes X, No _____

5	TYPE OF BLANK CASING USED:		5 Wrought iron	8 Concrete tile	CASING JOINTS: Glued ☒ Clamped ☐ Welded ☐
	1 Steel	3 RMP (SR)	6 Asbestos-Cement	9 Other (specify below)	

Blank casing diameter 2 PVC in. to 4 ABS ft. Dia. 7 Fiberglass in. to Threated. ft. Dia. 1 1/2 PVC ft.

Casing height above land surface. 12 . . . in., weight 2.60 . . . lbs./ft. Wall thickness or gauge No. 160410

TYPE OF SCREEN OR PERFORATION MATERIAL:

1 Steel	3 Stainless steel	5 Fiberglass	8 RMP (SR)	10 Asbestos-cement
2 Brass	4 Galvanized steel	6 Concrete tile	9 ABS	11 Other (specify)
12 None used (open hole)				

SCREEN OR PERFORATION OPENINGS ARE:

1 Continuous slot 3 Mill slot 6 Wire wrapped 9 Drilled holes
2 Louvered shutter 4 Key punched 7 Torch cut 10 Other (specify)

SCREEN PERFORATED INTERVALS: ft. From ft. to ft.

GRAVEL BACK INTERVALS:

GRAVEL PACK INTERVALS:		From	18	ft. to	30	ft. From		ft. to		ft.
		From		ft. to		ft. From		ft. to		ft.

c. GROUT MATERIAL:	1. Neat cement	2. Cement grout	3. Bentonite	4. Other

6 GROUT MATERIAL: Neat cement 2 Cement grout 3 Bentonite 4 Other _____

Grout Intervals: From 3 ft. to 18 ft. From _____ ft. to _____ ft. From _____ ft. to _____ ft.

What is the nearest possible contamination: 10. Livestock pens 14. Abandoned water well

1 Septic tank	4 Lateral lines	7 Pit privy	10 Livestock pens	14 Abandoned water well
2 Sewer lines	5 Gas pool	8 Sewage lagoons	11 Fuel storage	15 Oil well/Gas well
			12 Fertilizer storage	16 Other (specify below)

2 Sewer lines	5 Cess pool	8 Sewage lagoon	12 Fertilizer storage	16 Other (specify below)
3 Watertight sewer lines	6 Seepage pit	9 Feedyard	13 Insecticide storage	

Direction from wall? _____
How many feet? _____

Direction from well?			How many feet?		
FROM	TO	LITHOLOGIC LOG	FROM	TO	PLUGGING INTERVALS

0	2	TOP SOIL
2	16	CLAY.
16	31	FINE SAND.
31	32	CLAY
32	50	GRAVEL.

7 CONTRACTOR'S OR LANDOWNER'S CERTIFICATION: This water well was (1) constructed, (2) reconstructed, or (3) plugged under my jurisdiction and was completed on (mo/day/year) 12-9-91 and this record is true to the best of my knowledge and belief. Kansas 15711791

Water Well Contractor's License No. 31A This Water Well Record was completed on (the day) 10 of August 2018
under the business name of Weninger Drilling, Inc. by (signature) [Signature]