


1 LOCATION OF WATER WELL: Fraction SW 1/4 NW 1/4 SW 1/4 Section Number 18 Township Number T 26 S Range Number R 1 E
 County: Sedgwick
 Distance and direction from nearest town or city street address of well if located within city: 1 W 12 No MAZE KS.

2 WATER WELL OWNER: DOLESE BROTHERS.
 RR#, St. Address, Box #: Bx 1841
 City, State, ZIP Code: Wichita KS 67201
 Board of Agriculture, Division of Water Resources
 Application Number:

3 LOCATE WELL'S LOCATION WITH AN "X" IN SECTION BOX:

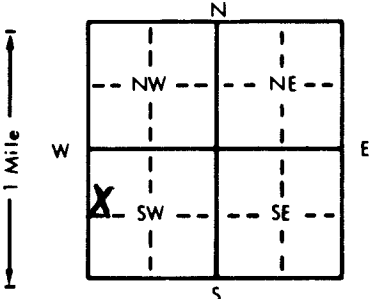

4 DEPTH OF COMPLETED WELL: 50 ft. ELEVATION:

Depth(s) Groundwater Encountered 1. 18 ft. 2. 18 ft. 3. 18 ft.

WELL'S STATIC WATER LEVEL 18 ft. below land surface measured on 9-12-84 mo/day/yr

Pump test data: Well water was 18 ft. after 50 hours pumping 50 gpm

Est. Yield 150 gpm: Well water was 18 ft. after 50 hours pumping 50 gpm

Bore Hole Diameter 14 in. to 50 ft. and 50 in. to 50 ft.

WELL WATER TO BE USED AS: 5 Public water supply 8 Air conditioning 11 Injection well

1 Domestic 3 Feedlot 6 Oil field water supply 9 Dewatering 12 Other (Specify below)

2 Irrigation 4 Industrial 7 Lawn and garden only 10 Observation well

Was a chemical/bacteriological sample submitted to Department? Yes No X If yes, mo/day/yr sample was submitted

Water Well Disinfected? Yes No X

5 TYPE OF BLANK CASING USED: 3 Wrought iron 8 Concrete tile CASING JOINTS: Glued X Clamped

1 Steel 3 RMP (SR) 6 Asbestos-Cement 9 Other (specify below) Welded

2 PVC 4 ABS 7 Fiberglass Threaded

Blank casing diameter 8 in. to 3.5 ft. Dia 3.80 in. to 160 PSI lbs./ft. Wall thickness or gauge No. 160 PSI

Casing height above land surface 16 in., weight 3.80 lbs./ft.

TYPE OF SCREEN OR PERFORATION MATERIAL: 7 PVC 10 Asbestos-cement

1 Steel 3 Stainless steel 5 Fiberglass 8 RMP (SR) 11 Other (specify)

2 Brass 4 Galvanized steel 6 Concrete tile 9 ABS 12 None used (open hole)

SCREEN OR PERFORATION OPENINGS ARE: 5 Gauzed wrapped 8 Saw cut 11 None (open hole)

1 Continuous slot 3 Mill slot 6 Wire wrapped 9 Drilled holes

2 Louvered shutter 4 Key punched 7 Torch cut 10 Other (specify)

SCREEN-PERFORATED INTERVALS: From 35 ft. to 50 ft. From 35 ft. to 50 ft.

GRAVEL PACK INTERVALS: From 20 ft. to 50 ft. From 20 ft. to 50 ft.

6 GROUT MATERIAL: 1 Neat cement 2 Cement grout 3 Bentonite 4 Other

Grout intervals: From 0 ft. to 20 ft. From 0 ft. to 20 ft.

What is the nearest source of possible contamination: 10 Livestock pens 14 Abandoned water well

1 Septic tank 4 Lateral lines 7 Pit privy 11 Fuel storage 15 Oil well/Gas well

2 Sewer lines 5 Cess pool 8 Sewage lagoon 12 Fertilizer storage 16 Other (specify below)

3 Watertight sewer lines 6 Seepage pit 9 Feedyard 13 Insecticide storage

Direction from well? SW NW How many feet? 100

FROM TO LITHOLOGIC LOG FROM TO LITHOLOGIC LOG

0 2 Top 50:1.

2 15 Clay

15 31 med sand.

31 33 Clay.

33 50 Gravel

7 CONTRACTOR'S OR LANDOWNER'S CERTIFICATION: This water well was (1) constructed, (2) reconstructed, or (3) plugged under my jurisdiction and was

completed on (mo/day/year) 3-18-84 and this record is true to the best of my knowledge and belief. Kansas

Water Well Contractor's License No. 318-12-84 This Water Well Record was completed on (mo/day/yr) 9-16-84

under the business name of Weninger Pumping by (signature) George Weninger

INSTRUCTIONS: Use typewriter or ball point pen, PLEASE PRESS FIRMLY and PRINT clearly. Please fill in blanks, underline or circle the correct answers. Send top

three copies to Kansas Department of Health and Environment, Division of Environment, Environmental Geology Section, Topeka, KS 66620. Send one to WATER WELL

OWNER and retain one for your records.

OFFICE USE ONLY

T

R

E

SEC.

18

SW

1/4

NW

1/4

SW

1/4