USE TYPEWRITER OR BALL POINT PEN-PRESS FIRMLY, PRINT CLEARLY.

WATER WELL RECORD
KSA 82a-1201-1215

Kansas Department of Health and Environment-Division of Environment
(Water well Contractors)
Topeka, Kansas 66620

1. Location of well:	County	Fraction	Section number	Township number	Range number
	Sedgwick	1/4 NE 1/4 NE 1/4	18	T 26 S	R 1W E/W

2. Distance and direction from nearest town or city: 6139 No. Maize Rd. Maize, Kansas
Street address of well location if in city:

3. Owner of well: Jim Henry
R.R. or street: 2406 Manhatten
City, state, zip code: Wichita, Kansas

4. Locate with "X" in section below:

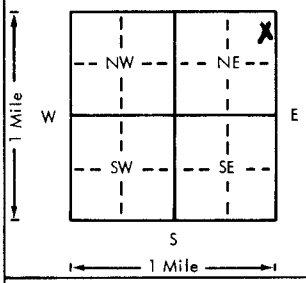

Sketch map:

6. Bore hole dia. 14 in. Completion date
Well depth 27 ft. 12-13-77

7. __ Cable tool X Rotary __ Driven __ Dug
__ Hollow rod __ Jetted __ Bored __ Reverse rotary

8. Use: X Domestic __ Public supply __ Industry
__ Irrigation __ Air conditioning __ Stock
__ Lawn __ Oil field water __ Other

9. Casing: Material ~~styrene~~ Height: Above or ~~below~~
Threaded __ Welded gl Surface 12 in.
RMP X PVC Weight lbs./ft.
Dia. 5 in. to 27 ft. depth Wall Thickness: inches or
Dia. in. to ft. depth gage No. .200

5. Type and color of material	From	To
Topsoil	0	3
Clay	3	6
Fine Sand	6	15
Medium Sand	15	27
(Use a second sheet if needed)		

10. Screen: Manufacturer's name Sunflower Plastic
Type styrene Dia. 5"
Slot/gauze ~~.06~~ .06 Length 10'
Set between 17 ft. and 27 ft.
ft. and ft.
Gravel pack? yes Size range of material 1/4-1/8"

11. Static water level: mo./day/yr.
14 ft. below land surface Date 12-13-77

12. Pumping level below land surfaces:
ft. after hrs. pumping g.p.m.
ft. after hrs. pumping g.p.m.
Estimated maximum yield g.p.m.

13. Water sample submitted: mo./day/yr.
__ Yes __ No Dote

14. Well head completion: capped
__ Pitless adapter 12 Inches above grade

15. Well grouted? yes 1-2 fine sand mix
With: __ Neat cement __ Bentonite __ Concrete
Depth: From 40" ft. to 14 ft.

16. Nearest source of possible contamination: NONE
ft. Direction Type
Well disinfected upon completion? X Yes __ No

17. Pump: X Not installed
Manufacturer's name
Model number HP Volts
Length of drop pipe ft. capacity g.p.m.
Type:
__ Submersible __ Turbine
__ Jet __ Reciprocating
__ Centrifugal __ Other

18. Elevation:

Topography:
__ Hill
__ Slope
__ Upland
__ Valley

19. Remarks:
Flat Ground

Septic System not installed at this time
No apparent source for contamination.

Pump not installed by our company.

20. Water well contractor's certification:
This well was drilled under my jurisdiction and this report is true to the best of my knowledge and belief.
Harp Well & Pump 236
Business name License No.
Address Wichita, Kansas
Signed M. Arnold Date
Authorized representative 12-31-77

T 26 R 1 W E Sec 18 1/4 1/4 1/4 NE NE

Forward the white, blue and pink copies to the Department of Health and Environment

Form WWC-5

MI-1023