

1 LOCATION OF WATER WELL: Fraction NW 1/4 NE 1/4 SE 1/4 Section Number 19 Township Number T 26 S Range Number R 1 E
 County: Sedgwick
 Distance and direction from nearest town or city street address of well if located within city?

720 OPAL maize KS
Troy Griffin
702 James
maize KS 67101

2 WATER WELL OWNER:

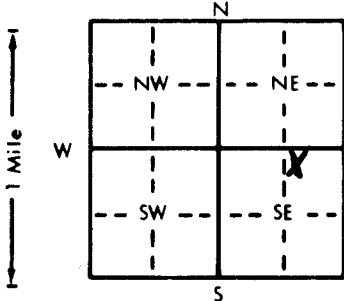
RR#, St. Address, Box # :

City, State, ZIP Code :

Board of Agriculture, Division of Water Resources

Application Number:

3 LOCATE WELL'S LOCATION WITH AN "X" IN SECTION BOX:

4 DEPTH OF COMPLETED WELL: 50 ft. ELEVATION:Depth(s) Groundwater Encountered 1. 16 ft. 2. 16 ft. 3. 4-15-85 ft.WELL'S STATIC WATER LEVEL 16 ft. below land surface measured on mo/day/yr 4-15-85Pump test data: Well water was 16 ft. after 12 hours pumping 20 gpmEst. Yield 50 gpm: Well water was 16 ft. after 12 hours pumping 20 gpmBore Hole Diameter 11 in. to 50 ft., and 50 in. to 50 ft.

WELL WATER TO BE USED AS: 5 Public water supply 8 Air conditioning 11 Injection well

1 Domestic 3 Feedlot 6 Oil field water supply 9 Dewatering 12 Other (Specify below)

2 Irrigation 4 Industrial 7 Lawn and garden only 10 Observation well

Was a chemical/bacteriological sample submitted to Department? Yes X No X; If yes, mo/day/yr sample was submittedWater Well Disinfected? Yes X No

5 TYPE OF BLANK CASING USED:

- 1 Steel
 2 PVC
 3 RMP (SR)
 4 ABS

- 5 Wrought iron
 6 Asbestos-Cement
 7 Fiberglass

- 8 Concrete tile
 9 Other (specify below)

CASING JOINTS: Glued X Clamped
 Welded
 Threaded

Blank casing diameter 5 in. to 40 ft., Dia. 40 in. to 50 ft., Dia. 50 in. to 50 ft.Casing height above land surface 12 in., weight 1.59 lbs./ft. Wall thickness or gauge No 5 OR 26

TYPE OF SCREEN OR PERFORATION MATERIAL:

- 1 Steel
 2 Brass
 3 Stainless steel
 4 Galvanized steel

- 5 Fiberglass
 6 Concrete tile

- 7 PVC
 8 RMP (SR)
 9 ABS

- 10 Asbestos-cement
 11 Other (specify)
 12 None used (open hole)

SCREEN OR PERFORATION OPENINGS ARE:

- 1 Continuous slot
 2 Louvered shutter
 3 Mill slot
 4 Key punched

- 5 Gauzed wrapped
 6 Wire wrapped
 7 Torch cut

- 8 Saw cut
 9 Drilled holes
 10 Other (specify)
 11 None (open hole)

SCREEN-PERFORATED INTERVALS: From 40 ft. to 50 ft., From 40 ft. to 50 ft., From 40 ft. to 50 ft., From 40 ft. to 50 ft.GRAVEL PACK INTERVALS: From 10 ft. to 50 ft., From 10 ft. to 50 ft., From 10 ft. to 50 ft., From 10 ft. to 50 ft.

6 GROUT MATERIAL:

- 1 Neat cement

- 2 Cement grout

- 3 Bentonite

- 4 Other

Grout Intervals: From 0 ft. to 10 ft., From 0 ft. to 10 ft., From 0 ft. to 10 ft., From 0 ft. to 10 ft.

What is the nearest source of possible contamination:

- 1 Septic tank
 2 Sewer lines
 3 Wateright sewer lines
 4 Lateral lines
 5 Cess pool
 6 Seepage pit
 7 Pit privy
 8 Sewage lagoon
 9 Feedyard

- 10 Livestock pens
 11 Fuel storage
 12 Fertilizer storage
 13 Insecticide storage
 14 Abandoned water well
 15 Oil well/Gas well
 16 Other (specify below)

Direction from well?

EASTHow many feet? 15

FROM	TO	LITHOLOGIC LOG	FROM	TO	LITHOLOGIC LOG
0	2	Top soil			
2	16	Clay			
16	34	fine sand			
34	35	Clay			
35	50	Sand			

7 CONTRACTOR'S OR LANDOWNER'S CERTIFICATION: This water well was (1) constructed, (2) reconstructed, or (3) plugged under my jurisdiction and was completed on (mo/day/year) 4-15-85 and this record is true to the best of my knowledge and belief, KansasWater Well Contractor's License No. 318 This Water Well Record was completed on (mo/day/yr) 4-15-85under the business name of Waninger Drilling by (signature) Donnell K. Waninger

INSTRUCTIONS: Use typewriter or ball point pen. PLEASE PRESS FIRMLY and PRINT clearly. Please fill in blanks, underline or circle the correct answers. Send top three copies to Kansas Department of Health and Environment, Division of Environment, Environmental Geology Section, Topeka, KS 66620. Send one to WATER WELL OWNER and retain one for your records.

OFFICE USE ONLY

T

R

1

EW

SEC.

19

NW

NE

SE

SW