USE TYPEWRITER OR BALL POINT PEN-PRESS FIRMLY, PRINT CLEARLY.

T R EW sec 1/4 1/4 1/4 No.

WATER WELL RECORD
KSA 82a-1201-1215

Kansas State Dept. Of Health
(Water Well Contractors)
Forbes-Bldg. 740
Topeka, Kansas 66620

1 Location of well:	County	Township name	Fraction	Section number	Town number	Range number
	Sedgwick	Park	SW-NE-SE	19	T-26-~~N~~	R1W

Distance and direction from nearest town or city:

Street address of well location if in city: 112 Zelda, Maize, 67101

3 Owner of well: William Applegate

Address: 112 Zelda, Maize 67101

Locate with "X" in section below:

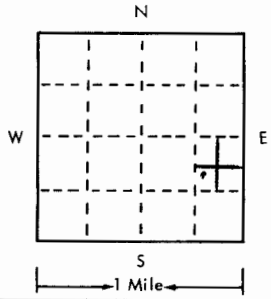

Sketch map:

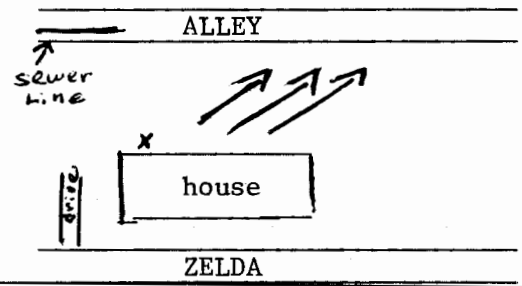

4 Well depth: 39 ft. Date of completion 7-26-80
Well diameter 9 in.

5 ☐ Cable tool ☐ Rotary ☐ Driven ☐ Dug
☐ Hollow rod ☐ Jetted ☒ Bored ☐ Reverse rotary

6 Use: ☒ Domestic ☐ Public supply ☐ Industry
☐ Irrigation ☐ Air conditioning ☐ Commercial
☐ Test well ☐

7 Casing: Material RMP Height: above/below
Threaded ☐ Welded ☐ Surface 13 in.
Diam. glued Weight 200 lbs./ft.
6 in. to 39 ft. depth Drive shoe? ☐ Yes ☒ No
in. to ft. depth

2

Type and color of material	From	To
red clay	0	8
fine sand	8	12
coarse sand	12	39
water begins at 22 feet		
(use a second sheet if needed)		

8 Screen:
Manufacturer Sunflower
Type RMP Dia. 6 in.
Slot/gauze .050 Length 10 ft.
Set between 29 ft. and 39 ft.
Fittings:
Gravel pack ☐ Yes ☒ No Size range of material

9 Static water level:
22 ft. below land surface Date 7-26-80

10 Pumping level below land surfaces:
ft. after hrs. pumping g.p.m.
ft. after hrs. pumping g.p.m.
Estimated maximum yield g.p.m.

11 Water sample submitted:
☐ Yes ☒ No Date

12 Well head completion: 12"
☐ Pitless adapter ☐ Inches above grade

13 Well grouted? ☒ Yes ☐ No
☒ Neat cement ☐ Bentonite ☐
Depth: From 0 ft. to 10 ft.

14 Nearest source of possible contamination: sewer line
ft. 50 Direction N Type
Well disinfected upon completion? ☒ Yes ☐ No

15 Pump: ☒ Not installed
Manufacturer's name
Model number HP Volts
Length of drop pipe ft. capacity g.m.p.
Type:
☐ Submersible ☐ Turbine
☐ Jet ☐ Reciprocating
☐ Centrifugal ☐ Other

16 Remarks: elevation

Topography:
☐ Hill
☒ Slope
☐ Upland
☐ Valley

17 Water well contractor's certification:
This well was drilled under my jurisdiction and this report is true to the best of my knowledge and belief.
Whitchurch Well Serv. 309
Business name License No.
Address 520 James St. Maize, Ks.
Signed [signature] Date 8/80
Authorized representative

26 1W 19 SWNESE

Forward the white, blue and pink copies to the Kansas State Dept. Of Health.

Form WWC-5

677-H