USE TYPEWRITER OR BALL POINT PEN-PRESS FIRMLY, PRINT CLEARLY.

WATER WELL RECORD
KSA 82a-1201-1215

Kansas Department of Health and Environment-Division of Environment
(Water well Contractors)
Topeka, Kansas 66620

1. Location of well: County: Sedg. Fraction: ~~SE~~ SE 1/4 NE 1/4 SE 1/4 Section number: 19 Township number: T 26 S Range number: R 1 E (W)

2. Distance and direction from nearest town or city:
Street address of well location if in city: 629 Queen Maize Ks 67101

3. Owner of well: Ralph Bigelow
R.R. or street: 635 Queen
City, state, zip code: Maize Ks 67101

4. Locate with "X" in section below: Sketch map:

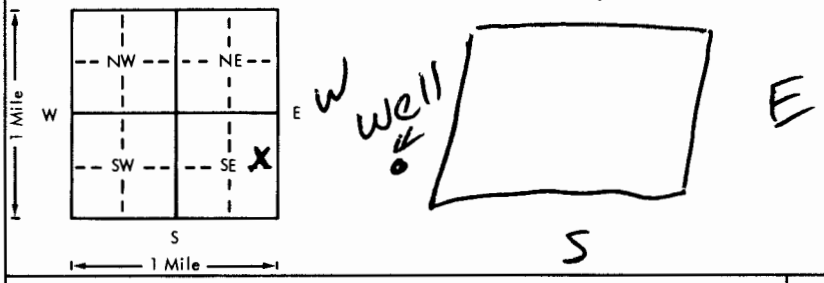

6. Boring hole dia. 11 in. Completion date: 8/18/77
Well depth 45 ft.

7. ___ Cable tool X Rotary ___ Driven ___ Dug
___ Hollow rod ___ Jetted ___ Bored ___ Reverse rotary

8. Use: X Domestic ___ Public supply ___ Industry
___ Irrigation ___ Air conditioning ___ Stock
___ Lawn ___ Oil field water ___ Other

9. Casing: Material PVC Height: (Above) or below
Threaded ___ Welded ___ Surface 12 in.
RMP ___ PVC X Weight 2.31 lbs./ft.
Dia. 5 in. to 45 ft. depth Wall Thickness: inches or
Dia. ___ in. to ___ ft. depth gage No. 12/14

5. Type and color of material	From	To
Top soil.	0	6
redish clay.	6	18
med sand	18	26
red clay layer	26	27
med to course gravel	27	45

10. Screen: Manufacturer's name MPI
Type PVC Dia. 5 in.
Slot/gauze 1116 Length 5 ft
Set between 40 ft. and 45 ft.
___ ft. and ___ ft.
Gravel pack? Yes Size range of material 3/8

11. Static water level: mo./day/yr.
22 ft. below land surface Date 8/18/77

12. Pumping level below land surfaces:
23 ft. after 1/2 hrs. pumping 20 g.p.m.
___ ft. after ___ hrs. pumping ___ g.p.m.
Estimated maximum yield 50 g.p.m.

13. Water sample submitted: mo./day/yr.
___ Yes X No Date ___

14. Well head completion:
X Pitless adapter 12 Inches above grade

15. Well grouted? Yes
With: X Neat cement ___ Bentonite ___ Concrete
Depth: From 3 ft. to 13 ft.

16. Nearest source of possible contamination:
ft. ___ Direction NONE Type ___
Well disinfected upon completion? X Yes ___ No

17. Pump: ___ Not installed
Manufacturer's name Pumpco
Model number 10S2P HP 1/2 Volts 220
Length of drop pipe 30 ft. capacity 12 g.p.m.
Type:
X Submersible ___ Turbine
___ Jet ___ Reciprocating
___ Centrifugal ___ Other

(Use a second sheet if needed)

18. Elevation:
Topography:
___ Hill
___ Slope
X Upland
___ Valley

19. Remarks: Contractor to furnish 4x4x4 reinforced slap ~~at~~ around well casing

20. Water well contractor's certification:
This well was drilled under my jurisdiction and this report is true to the best of my knowledge and belief.
Wemyss Drilling 318
Business name Colwich License No.
Address
Signed Jeanne Wemyss Date 8/19/77
Authorized representative

T 26 R 1 (W) E Sec 19 1/4 SE 1/4 1/4 SE 1/4

Forward the white, blue and pink copies to the Department of Health and Environment

Form WWC-5

MI-1023