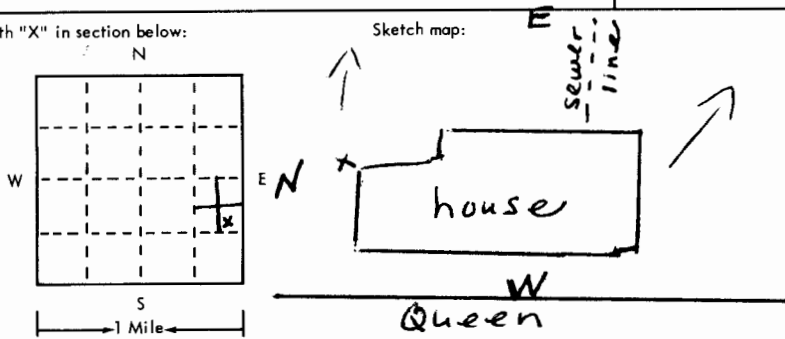


USE TYPEWRITER OR BALL
POINT PEN-PRESS FIRMLY,
PRINT CLEARLY.

WATER WELL RECORD
KSA 82a-1201-1215

T R EW sec 1/4 1/4 1/4 No.

Kansas State Dept. Of Health
(Water Well Contractors)
Forbes-Bldg. 740
Topeka, Kansas 66620

1 Location of well:	County Sedgwick	Township name Park	Fraction SE, NE, SE	Section number 19	Town number T-26-S	Range number R1W
Distance and direction from nearest town or city: Street address of well location if in city: SAME			3 Owner of well: Willia M. Copenhagen Address: 546 Queen MAIZE, KANS. 67101			
Locate with "X" in section below: 			4 Well depth: 35 ft. Date of completion 5-2-76 Well diameter 10 in.			
2 Type and color of material			5 ☐ Cable tool ☐ Rotary ☐ Driven ☐ Dug ☐ Hollow rod ☐ Jetted ☒ Bored ☐ Reverse rotary			
			6 Use: ☒ Domestic ☐ Public supply ☐ Industry ☐ Irrigation ☐ Air conditioning ☐ Commercial ☐ Test well ☐			
From To			7 Casing: Material RMP Height: above/below Threaded ☐ Welded ☐ Surface 13 in. Diam. 6 in. to 25 ft. depth Drive shoe? ☐ Yes ☒ No			
			8 Screen: Sunflower Manufacturer RMP Dia. 6 Type 075 Length 2 Set between 25 ft. and 35 ft. Fittings: Gravel pack ☐ Yes ☒ No Size range of material			
(use a second sheet if needed)			9 Static water level: 12 ft. below land surface Date 4-29-76			
			10 Pumping level below land surfaces: ____ ft. after ____ hrs. pumping ____ g.p.m. ____ ft. after ____ hrs. pumping ____ g.p.m. Estimated maximum yield ____ g.p.m.			
16 Remarks: elevation Topography: ☒ Hill ☐ Slope ☐ Upland ☐ Valley			11 Water sample submitted: ☐ Yes ☒ No Date ____			
			12 Well head completion: 13 ☐ Pitless adapter ☒ Inches above grade			
			13 Well grouted? ☒ Yes ☐ No ☒ Neat cement ☐ Bentonite ☐ Depth: From 0 ft. to 10 ft.			
			14 Nearest source of possible contamination: sewer line ft. 25 Direction S Type line Well disinfected upon completion? ☒ Yes ☐ No			
			15 Pump: ☒ Not installed Manufacturer's name _____ Model number _____ HP _____ Volts _____ Length of drop pipe _____ ft. capacity _____ g.p.m. Type: ☐ Submersible ☐ Turbine ☐ Jet ☐ Reciprocating ☐ Centrifugal ☐ Other			
			17 Water well contractor's certification: This well was drilled under my jurisdiction and this report is true to the best of my knowledge and belief. Whitchurch Well Service Business name _____ License No. _____ Address 520 James, Maize Signed W. Whitchurch Date 5-2-76 Authorized representative			

Forward the white, blue and pink copies to the Kansas State Dept. Of Health.

Form WWC-5