USE TYPEWRITER OR BALL POINT PEN–PRESS FIRMLY, PRINT CLEARLY.

WATER WELL RECORD
KSA 82a-1201-1215

Kansas Department of Health and Environment–Division of Environment
(Water well Contractors)
Topeka, Kansas 66620

1. Location of well: County: Sedgwick. Fraction: NW 1/4 SW 1/4 SE 1/4. Section number: 19. Township number: T 26 S. Range number: R 1 E/W (W circled)

2. Distance and direction from nearest town or city:
Street address of well location if in city: 726 Surry Ln. Maize KS.

3. Owner of well: TRoy Griffin
R.R. or street: 702 James
City, state, zip code: MAIZE KS 67101

4. Locate with "X" in section below:

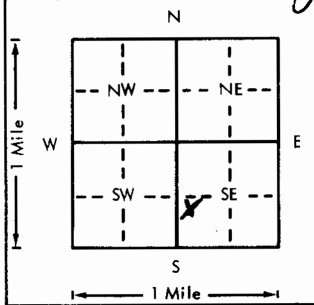

Sketch map:

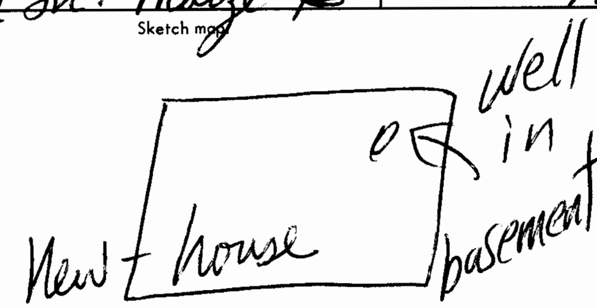

6. Bore hole dia. 11 in. Completion date 2/28/78
Well depth 52 ft.

7. ___ Cable tool X Rotary ___ Driven ___ Dug
___ Hollow rod ___ Jetted ___ Bored ___ Reverse rotary

8. Use: X Domestic ___ Public supply ___ Industry
___ Irrigation ___ Air conditioning ___ Stock
___ Lawn ___ Oil field water ___ Other

9. Casing: Material PVC Height: Above (circled) or below
Threaded ___ Welded X Surface 12 in.
RMP ___ PVC X Weight 2.76 lbs./ft.
Dia. 5 in. to 52 ft. depth Wall Thickness: inches or
Dia. ___ in. to ___ ft. depth gage No. 258

10. Screen: Manufacturer's name M.P.I.
Type Sch 40 Dia. 5 in
Slot (circled)/gauze 1/16 Length 10 ft
Set between 42 ft. and 52 ft.
___ ft. and ___ ft.
Gravel pack? yes Size range of material 3/8

11. Static water level: mo./day/yr.
22 ft. below land surface Date 2/28/78

12. Pumping level below land surfaces:
23 ft. after 1/2 hrs. pumping 20 g.p.m.
___ ft. after ___ hrs. pumping ___ g.p.m.
Estimated maximum yield 100 g.p.m.

13. Water sample submitted: mo./day/yr.
___ Yes X No Date ___

14. Well head completion:
___ Pitless adapter 12 Inches above grade

15. Well grouted? yes
With: ___ Neat cement ___ Bentonite X Concrete
Depth: From 6 ft. to 16 ft.

16. Nearest source of possible contamination:
ft. ___ Direction none Type ___
Well disinfected upon completion? X Yes ___ No

17. Pump: X Not installed
Manufacturer's name ___
Model number ___ HP ___ Volts ___
Length of drop pipe ___ ft. capacity ___ g.p.m.
Type:
___ Submersible ___ Turbine
___ Jet ___ Reciprocating
___ Centrifugal ___ Other

5. Type and color of material

5. Type and color of material	From	To
Top Soil	0	4
red clay.	4	18
fine to med. sand.	18	32
red clay.	32	33
med. to Course gravel	33	52

(Use a second sheet if needed)

18. Elevation:

Topography:
___ Hill
___ Slope
X Upland
___ Valley

19. Remarks:

20. Water well contractor's certification:
This well was drilled under my jurisdiction and this report is true to the best of my knowledge and belief.
Wenninger Drilling 318
Business name License No.
Address Colwich KS
Signed [signature] Authorized representative Date 2/28/78

Forward the white, blue and pink copies to the Department of Health and Environment

Form WWC-5

T 26 R 1 W Sec 19 1/4 1/4 1/4 NWSWSE

MI-1023