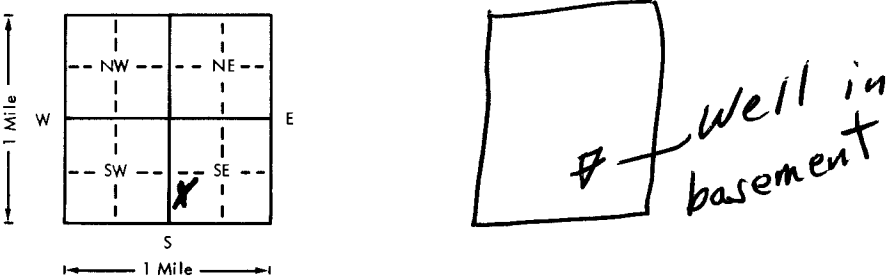


USE TYPEWRITER OR BALL
POINT PEN-PRESS FIRMLY,
PRINT CLEARLY.

WATER WELL RECORD
KSA 82a-1201-1215

Kansas Department of Health and
Environment-Division of Environment
(Water well Contractors)
Topeka, Kansas 66620

1. Location of well: County <u>Sedgwick</u> Fraction <u>NW 1/4 SW 1/4 SE 1/4</u> Section number <u>19</u> Township number <u>T 26 S</u> Range number <u>R 1 E</u>	
2. Distance and direction from nearest town or city: Street address of well location if in city: <u>810 Sunny Ln Maize Ks.</u> 3. Owner of well: <u>Carroll Harder</u> R.R. or street: <u>Box 126</u> City, state, zip code: <u>Peabody Ks 66866</u>	
4. Locate with "X" in section below: Sketch map: 	
6. Bore hole dia. <u>5 1/2</u> in. Completion date <u>1/31/78</u> Well depth <u>53</u> ft.	
7. ☒ Cable tool ☒ Rotary ☐ Driven ☐ Dug ☐ Hollow rod ☐ Jetted ☐ Bored ☐ Reverse rotary	
8. Use: ☒ Domestic ☐ Public supply ☐ Industry ☐ Irrigation ☐ Air conditioning ☐ Stock ☐ Lawn ☐ Oil field water ☐ Other	
9. Casing: Material <u>PVC</u> Height: <u>Above</u> or below <u>Surface</u> Threading: <u>Welded</u> <u>X</u> Surface <u>12</u> in. RMP <u>PVC</u> <u>X</u> Weight <u>2.76</u> lbs./ft. Dia. <u>5</u> in. to <u>5 1/2</u> ft. depth Wall Thickness: inches or Dia. <u>5</u> in. to <u>5 1/2</u> ft. depth gage No. <u>258</u>	
10. Screen: Manufacturer's name <u>M.P.I.</u> Type <u>PVC</u> Dia. <u>5 in</u> Slot gauge <u>11/16</u> Length <u>10 ft</u> Set between <u>43</u> ft. and <u>53</u> ft. Gravel pack? <u>Yes</u> Size range of material <u>3/8</u>	
11. Static water level: <u>24</u> ft. below land surface Date <u>1/31/78</u> mo./day/yr.	
12. Pumping level below land surfaces: <u>25</u> ft. after <u>12</u> hrs. pumping <u>20</u> g.p.m. <u>65</u> g.p.m. Estimated maximum yield <u>65</u> g.p.m.	
13. Water sample submitted: <u>X</u> Yes <u>X</u> No Date <u>1/31/78</u> mo./day/yr.	
14. Well head completion: <u>12</u> Pitless adapter <u>12</u> inches above grade	
15. Well grouted? <u>Yes</u> With: <u>Neat cement</u> <u>X</u> Bentonite <u>X</u> Concrete Depth: From <u>6</u> ft. to <u>16</u> ft.	
16. Nearest source of possible contamination: ft. <u>None</u> Direction <u>None</u> Type <u>None</u> Well disinfected upon completion? <u>X</u> Yes <u>None</u> No	
17. Pump: <u>X</u> Not installed Manufacturer's name <u>Weninger Dilling</u> Model number <u>318</u> HP <u>1/4</u> Volts <u>115</u> Length of drop pipe <u>19</u> ft. capacity <u>1/4</u> g.p.m. Type: <u>Submersible</u> <u>Turbine</u> <u>Jet</u> <u>Reciprocating</u> <u>Centrifugal</u> <u>Other</u>	
20. Water well contractor's certification: This well was drilled under my jurisdiction and this report is true to the best of my knowledge and belief. <u>Weninger Dilling</u> Business name <u>318</u> License No. <u>19 NW 1/4 SE 1/4</u> Address <u>Peabody Ks</u> Signed <u>James Dilling</u> Date <u>1/31/78</u> Authorized representative	
5. Type and color of material	
Top soil 0 4	
Red clay 4 18	
fine sand 18 38	
COARSE GRAVEL 38 52	
GRAY clay 52 53	
18. Elevation: Topography: <u>X</u> Hill <u>X</u> Slope <u>X</u> Upland <u>X</u> Valley	
19. Remarks: (Use a second sheet if needed)	

Forward the white, blue and pink copies to the Department of Health and Environment

Form WWC-5