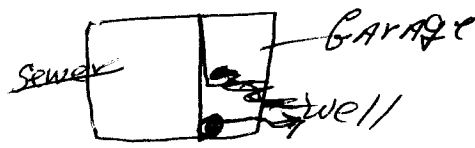


USE TYPEWRITER OR BALL
POINT PEN-PRESS FIRMLY,
PRINT CLEARLY.

WATER WELL RECORD
KSA 82a-1201-1215

Kansas Department of Health and
Environment-Division of Environment
(Water well Contractors)
Topeka, Kansas 66620

1. Location of well:		County <u>Sedgwick</u>	Fraction <u>NW 1/4 SE 1/4 SE 1/4</u>	Section number <u>19</u>	Township number <u>T 24</u>	Range number <u>S R 1 W E</u>
2. Distance and direction from nearest town or city: Street address of well location if in city: <u>714 Queen</u>				3. Owner of well: <u>Troy Griffin Const. Co</u> R.R. or street: <u>702 James</u> City, state, zip code: <u>Mazie KS. 67101</u>		
4. Locate with "X" in section below: N W E S 1 Mile Sketch map: 				6. Bore hole dia. <u>9</u> in. Completion date <u>5-9-77</u> Well depth <u>47</u> ft.		
5. Type and color of material				7. ☐ Cable tool ☐ Rotary ☐ Driven ☐ Dug ☐ Hollow rod ☐ Jetted ☒ Bored ☐ Reverse rotary		
				8. Use: ☒ Domestic ☐ Public supply ☐ Industry ☐ Irrigation ☐ Air conditioning ☐ Stock ☐ Lawn ☐ Oil field water ☐ Other		
				9. Casing: Material <u>PVC</u> Height: <u>(0)</u> Above or below Threaded ☐ Welded <u>OK</u> Surface <u>12</u> in. RMP ☐ PVC <u>X</u> Weight <u> </u> lbs./ft. Dia. <u>4</u> in. to <u>0</u> ft. depth Wall Thickness: inches or Dia. <u>6</u> in. to <u>47</u> ft. depth gage No. <u>0320</u>		
				10. Screen: Manufacturer's name <u>Sunflower mfg Co</u> Type <u>PVC</u> Dia. <u>6"</u> Slot/gauze <u>3/16</u> Length <u>5 ft</u> Set between <u>42</u> ft. and <u>47</u> ft. <u> </u> ft. and <u> </u> ft. Gravel pack? ☐ Size range of material <u> </u>		
				11. Static water level: <u>24</u> ft. below land surface Date <u>5-9-77</u> mo./day/yr.		
(Use a second sheet if needed)				12. Pumping level below land surfaces: <u> </u> ft. after <u> </u> hrs. pumping <u> </u> g.p.m. <u> </u> ft. after <u> </u> hrs. pumping <u> </u> g.p.m. Estimated maximum yield <u>50</u> g.p.m.		
				13. Water sample submitted: <u> </u> mo./day/yr. ☐ Yes ☒ No Date <u> </u>		
				14. Well head completion: ☐ Pitless adapter <u>12</u> inches above grade		
				15. Well grouted? <u>yes</u> With: ☐ Neat cement ☐ Bentonite ☒ Concrete Depth: From <u>0</u> ft. to <u>10</u> ft.		
				16. Nearest source of possible contamination: <u>ABS Sewer</u> ft. <u>15</u> Direction <u>SW</u> Type <u>Sewer</u> Well disinfected upon completion? ☒ Yes ☐ No		
				17. Pump: ☒ Not installed Manufacturer's name <u> </u> Model number <u> </u> HP <u> </u> Volts <u> </u> Length of drop pipe <u> </u> ft. capacity <u> </u> g.p.m. Type: ☐ Submersible ☐ Turbine ☐ Jet ☐ Reciprocating ☐ Centrifugal ☐ Other		
				18. Elevation:		
				19. Remarks:		
				20. Water well contractor's certification: This well was drilled under my jurisdiction and this report is true to the best of my knowledge and belief. <u>Protheroe Pump & Well</u> <u>295</u> Business name License No. Address <u>927 W. 27th St</u> Signed <u>Protheroe</u> Date <u>5-17-77</u> Authorized representative		
				Topography: ☐ Hill ☒ Slope ☐ Upland ☐ Valley		

Forward the white, blue and pink copies to the Department of Health and Environment

Form WWC-5