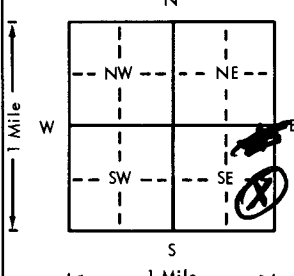
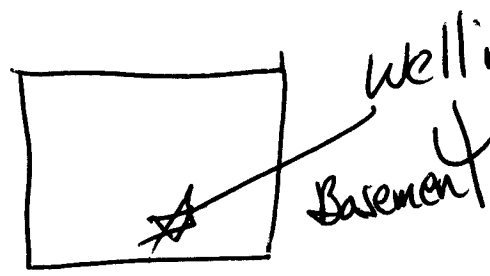


USE TYPEWRITER OR BALL
POINT PEN-PRESS FIRMLY,
PRINT CLEARLY.

WATER WELL RECORD
KSA 82a-1201-1215

Kansas Department of Health and
Environment-Division of Environment
(Water well Contractors)
Topeka, Kansas 66620

1. Location of well:		County <u>Sedg.</u>	Fraction <u>NE 1/4 SE 1/4 SE 1/4</u>	Section number <u>19</u>	Township number <u>T 26 S R 1 E</u>	Range number <u>1</u>
2. Distance and direction from nearest town or city:		3. Owner of well: <u>Troy Griffin Const.</u>				
Street address of well location if in city: <u>740 Queen Maize St.</u>		R.R. or street: <u>702 James Maize</u>				
City, state, zip code: <u>Maize, KS 67101</u>						
4. Locate with "X" in section below:		Sketch map:				
						
5. Type and color of material		From	To	6. Bore hole dia. <u>50</u> in. Completion date: <u>10/14/77</u>		
<u>Top soil.</u>		<u>0</u>	<u>4</u>	Well depth <u>50</u> ft.		
<u>Red clay</u>		<u>4</u>	<u>18</u>	7. Cable tool ☒ Rotary ☐ Driven ☐ Dug		
<u>med. sand</u>		<u>18</u>	<u>31</u>	☐ Hollow rod ☐ Jetted ☐ Bored ☐ Reverse rotary		
<u>clay.</u>		<u>31</u>	<u>32</u>	8. Use: ☒ Domestic ☐ Public supply ☐ Industry		
<u>med to coarse gravel</u>		<u>32</u>	<u>50</u>	☐ Irrigation ☐ Air conditioning ☐ Stock		
				☐ Lawn ☐ Oil field water ☐ Other		
				9. Casing: Material ☒ Height: <u>Above</u> or below		
				Threaded ☐ Welded ☒ Surface <u>1 1/2</u> in.		
				RMP ☐ PVC ☒ Weight <u>2 3/4</u> lbs./ft.		
				Dia. <u>5</u> in. to <u>50</u> ft. depth		
				Well Thickness: inches <u>2 1/4</u>		
				Dia. <u>5</u> in. to <u>50</u> ft. depth		
				gauge No. <u>2 1/4</u>		
				10. Screen: Manufacturer's name <u>M.P.I.</u>		
				Type <u>PVC</u> Dia. <u>5 1/4</u>		
				Flow gauge <u>1 1/16</u> length <u>60</u> ft.		
				Set between <u>40</u> ft. and <u>50</u> ft.		
				<u>ft.</u> and <u>ft.</u>		
				Gravel pack? ☒ Size range of material <u>3/8</u>		
				11. Static water level: <u>22</u> ft. below land surface Date <u>10/14/77</u>		
				mo./day/yr. <u>10/14/77</u>		
				12. Pumping level below land surfaces:		
				<u>23</u> ft. after <u>12</u> hrs. pumping <u>20</u> g.p.m.		
				<u>ft.</u> after <u>hrs.</u> pumping <u>g.p.m.</u>		
				Estimated maximum yield <u>100</u> g.p.m.		
				13. Water sample submitted: <u>Yes</u> ☒ No ☐ Date <u>10/14/77</u>		
				mo./day/yr. <u>10/14/77</u>		
				14. Well head completion: <u>12</u> inches above grade		
				☐ Pitless adapter <u>12</u> inches above grade		
				15. Well grouted? <u>Yes</u>		
				With: ☒ Neat cement ☐ Bentonite ☐ Concrete		
				Depth: From <u>6</u> ft. to <u>16</u> ft.		
				16. Nearest source of possible contamination: <u>NONE</u>		
				ft. <u>NONE</u> Direction <u>NONE</u>		
				Well disinfected upon completion? ☒ Yes ☐ No		
				17. Pump: ☒ Not installed		
				Manufacturer's name <u>Wenger</u>		
				Model number <u>318</u> HP <u>1/2</u> Volts <u>115</u>		
				Length of drop pipe <u>16</u> ft. capacity <u>20</u> g.p.m.		
				Type: ☐ Submersible ☐ Turbine		
				☐ Jet ☐ Reciprocating		
				☐ Centrifugal ☐ Other		
18. Elevation:		19. Remarks:				

Forward the white, blue and pink copies to the Department of Health and Environment

Form WWC-5