USE TYPEWRITER OR BALL POINT PEN-PRESS FIRMLY, PRINT CLEARLY.

WATER WELL RECORD
KSA 82a-1201-1215

Kansas Department of Health and Environment-Division of Environment
(Water well Contractors)
Topeka, Kansas 66620

1. Location of well:	County	Fraction	Section number	Township number	Ronge number
	Sedg.	NE¼ SE¼ SE¼	19	T 26 S	R 1 E/W

2. Distance and direction from nearest town or city:
Street address of well location if in city: 743 Opal Maize KS.

3. Owner of well: FRANK Pegg
R.R. or street: 742 atherton
City, state, zip code: Maize KS 67101

4. Locate with "X" in section below:

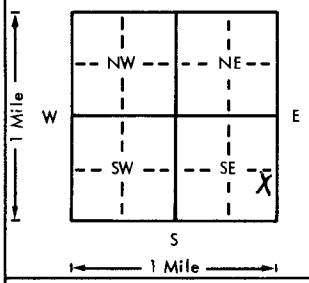

Sketch map:

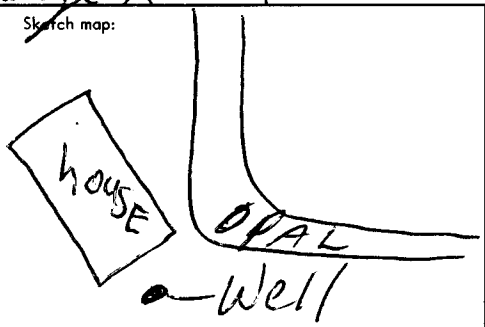

6. Bore hole dia. 11 in. Completion date 2/25/78
Well depth 49 ft.

7. __ Cable tool X Rotary __ Driven __ Dug
__ Hollow rod __ Jetted __ Bored __ Reverse rotary

8. Use: X Domestic __ Public supply __ Industry
__ Irrigation __ Air conditioning __ Stock
__ Lawn __ Oil field water __ Other

9. Casing: Material PVC Height: Above or below
Threaded __ Welded X Surface 12 in.
RMP __ PVC X Weight 2.26 lbs./ft.
Dia. 5 in. to 49 ft. depth Wall Thickness: inches or
Dia. __ in. to __ ft. depth gage No. 1258

5. Type and color of material	From	To
Top soil.	0	4
Red clay.	4	18
fine to med. sand	18	33
red clay.	33	34
course gravel	34	49

(Use a second sheet if needed)

10. Screen: Manufacturer's name M.P.I.
Type Sch 40 Dia. 5 in
Slot/gauze 1/16 Length 10 ft.
Set between 39 ft. and 49 ft.
__ ft. and __ ft.
Gravel pack? Yes Size range of material 3/8

11. Static water level: mo./day/yr.
23 ft. below land surface Date 2/25/78

12. Pumping level below land surfaces:
24 ft. after 2 hrs. pumping 20 g.p.m.
__ ft. after __ hrs. pumping __ g.p.m.
Estimated maximum yield 75 g.p.m.

13. Water sample submitted: mo./day/yr.
__ Yes X No Date

14. Well head completion:
X Pitless adapter 12 Inches above grade

15. Well grouted? Yes
With: __ Neat cement __ Bentonite X Concrete
Depth: From 3 ft. to 13 ft.

16. Nearest source of possible contamination:
ft. __ Direction __ Type NONE
Well disinfected upon completion? X Yes __ No

17. Pump: __ Not installed
Manufacturer's name Ft W.
Model number 10518 HP 1/2 Volts 220
Length of drop pipe 35 ft. capacity 12 g.p.m.
Type:
X Submersible __ Turbine
__ Jet __ Reciprocating
__ Centrifugal __ Other

18. Elevation:

Topography:
__ Hill
__ Slope
X Upland
__ Valley

19. Remarks: Customer to furnish 4'x4'x4" Slab as required by State
X Frank Pegg

20. Water well contractor's certification:
This well was drilled under my jurisdiction and this report is true to the best of my knowledge and belief.
Duncan Drilling 318
Business name License No.
Address Coffeyville KS
Signed [signature] Date 2/25/78
Authorized representative

T 26 R 1 E/W Sec 19 1/4 NE 1/4 SE 1/4

Forward the white, blue and pink copies to the Department of Health and Environment

Form WWC-5

MI-1023