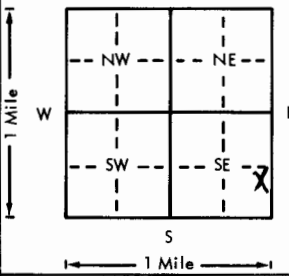
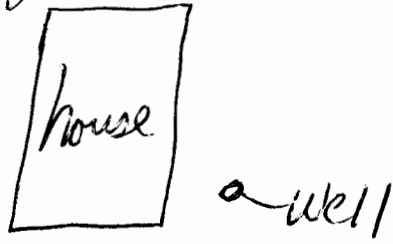


USE TYPEWRITER OR BALL
POINT PEN-PRESS FIRMLY,
PRINT CLEARLY.

WATER WELL RECORD
KSA 82a-1201-1215

Kansas Department of Health and
Environment-Division of Environment
(Water well Contractors)
Topeka, Kansas 66620

1. Location of well:		County <u>Sedg.</u>	Fraction <u>NE 1/4 SE 1/4 SE 1/4</u>	Section number <u>19</u>	Township number <u>T 26 S R 1</u>	Range number <u>1</u>
2. Distance and direction from nearest town or city:		Street address of well location if in city: <u>714 Opal Maize KS</u>		3. Owner of well: <u>Frank Peag</u> R.R. or street: <u>742 Orchard</u> City, state, zip code: <u>Maize KS 67101</u>		
4. Locate with "X" in section below:		Sketch map:		6. Bore hole dia. <u>1 1/2</u> in. Completion date <u>2/25/78</u> Well depth <u>47</u> ft.		
				7. ☒ Cable tool ☒ Rotary ☐ Driven ☐ Dug ☐ Hollow rod ☐ Jetted ☐ Bored ☐ Reverse rotary		
5. Type and color of material		From		To		8. Use: ☒ Domestic ☐ Public supply ☐ Industry ☐ Irrigation ☐ Air conditioning ☐ Stock ☐ Lawn ☐ Oil field water ☐ Other
<u>Top soil</u>		<u>0</u>		<u>4</u>		9. Casing: Material <u>PVC</u> Height: Above or below Threaded ☐ Welded ☒ Surface <u>12</u> in. RMP ☐ PVC ☒ Weight <u>2.76</u> lbs./ft. Dia. <u>5</u> in. to <u>4 1/2</u> ft. depth Wall Thickness: inches or Dia. <u>5</u> in. to <u>4 1/2</u> ft. depth gage No. <u>258</u>
<u>Red clay</u>		<u>4</u>		<u>17</u>		10. Screen: Manufacturer's name <u>M.P.E.</u> Type <u>Sch 40</u> Dia. <u>5 1/2</u> in. Slot gauge <u>1/16</u> Length <u>25</u> ft. Set between <u>4 1/2</u> ft. and <u>4 1/2</u> ft. <u>3</u> ft. and <u>3</u> ft. Gravel pack? ☒ Size range of material <u>3/8</u>
<u>fine sand</u>		<u>17</u>		<u>30</u>		11. Static water level: <u>22</u> ft. below land surface Date <u>2/25/78</u> no./day/yr.
<u>red clay</u>		<u>30</u>		<u>31</u>		12. Pumping level below land surfaces: <u>23</u> ft. after <u>1</u> hrs. pumping <u>20</u> g.p.m. <u>23</u> ft. after <u>1</u> hrs. pumping <u>20</u> g.p.m. Estimated maximum yield <u>50</u> g.p.m.
<u>coarse gravel</u>		<u>31</u>		<u>47</u>		13. Water sample submitted: <u>Yes</u> ☒ No Date <u>2/25/78</u> mo./day/yr.
<u>clay brake</u>		<u>47</u>				14. Well head completion: ☒ Pitless adapter <u>12</u> inches above grade
						15. Well grouted? <u>yes</u> With: ☐ Neat cement ☐ Bentonite ☒ Concrete Depth: From <u>3</u> ft. to <u>13</u> ft.
						16. Nearest source of possible contamination: fr. <u>10</u> ft. Direction <u>North</u> Well disinfected upon completion? ☐ Yes ☐ No
						17. Pump: <u>Not installed</u> Manufacturer's name <u>F.P.W.</u> Model number <u>10518</u> HP <u>1/2</u> Vol <u>220</u> Length of drop pipe <u>30</u> ft. capacity <u>12</u> g.p.m. Type: ☒ Submersible ☐ Turbine ☐ Jet ☐ Reciprocating ☐ Centrifugal ☐ Other
18. Elevation:		19. Remarks:		20. Water well contractor's certification:		
Topography: ☐ Hill ☐ Slope ☐ Upland ☐ Valley		<u>Customer to furnish 4x4x4</u> <u>slab as required by State</u> <u>X Peag</u>		This well was drilled under my jurisdiction and this report is true to the best of my knowledge and belief. <u>Whitney Pulling</u> <u>3/18</u> Business name <u>Copewell</u> License No. <u>KS</u> Address <u>Maize KS</u> Signed <u>James W. Winger</u> Date <u>2/25/78</u> Authorized representative		

Forward the white, blue and pink copies to the Department of Health and Environment

Form WWC-5