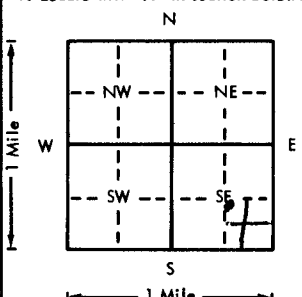


USE TYPEWRITER OR BALL
POINT PEN-PRESS FIRMLY,
PRINT CLEARLY.

WATER WELL RECORD
KSA 82a-1201-1215

Kansas Department of Health and
Environment-Division of Environment
(Water well Contractors)
Topeka, Kansas 66620

1. Location of well:		County Sedgwick	Fraction NW 1/4 SE 1/4 SE 1/4	Section number 19	Township number T 24 S	Range number R 1 E
2. Distance and direction from nearest town or city: Street address of well location if in city: 710 Atherton				3. Owner of well: Troy Griffin Const. R.R. or street: 702 James City, state, zip code: Lawrence KS 66044		
4. Locate with "X" in section below: 				Sketch map: 6. Bore hole dia. 10 in. Completion date 7-22-76 Well depth 45 ft.		
5. Type and color of material				7. ☐ Cable tool ☐ Rotary ☐ Driven ☐ Dug ☐ Hollow rod ☐ Jetted ☒ Bored ☐ Reverse rotary		
				8. Use: ☒ Domestic ☐ Public supply ☐ Industry ☐ Irrigation ☐ Air conditioning ☐ Stock ☐ Lawn ☐ Oil field water ☐ Other		
				9. Casing: Material PIT Height (Above or below) Threaded ☐ Welded ☒ Surface 12 in. RMP ☐ PVC ☒ Weight ☐ lbs./ft. Dia. 6 in. to 6 ft. depth Wall Thickness: inches or Dia. 6 in. to 45 ft. depth gage No. 132		
				10. Screen: Manufacturer's name Sunflower Math Co. Type PVC Dia. 6" Slot/gauze 3/16 Length 5' Set between 40 ft. and 45 ft. Gravel pack? NO Size range of material		
				11. Static water level: 28 ft. below land surface Date 7-22-76 12. Pumping level below land surfaces: ____ ft. after ____ hrs. pumping ____ g.p.m. ____ ft. after ____ hrs. pumping ____ g.p.m. Estimated maximum yield 50 g.p.m.		
(Use a second sheet if needed)				13. Water sample submitted: ____ mo./day/yr. Yes ☒ No ☐ Date		
				14. Well head completion: ____ Pitless adapter ____ Inches above grade		
				15. Well grouted? yes With: ____ Neat cement ____ Bentonite ☒ Concrete Depth: From 0 ft. to 11 ft.		
				16. Nearest source of possible contamination: AB5 ft. 15 Direction SE Type sewer Well disinfected upon completion? ____ Yes ☒ No		
				17. Pump: ☒ Not installed Manufacturer's name ____ Model number ____ HP ____ Volts ____ Length of drop pipe ____ ft. capacity ____ g.p.m. Type: ☐ Submersible ☐ Turbine ☐ Jet ☐ Reciprocating ☐ Centrifugal ☐ Other		
18. Elevation: Topography: ☒ Hill ☐ Slope ☐ Upland ☐ Valley	19. Remarks: well in Basement			20. Water well contractor's certification: This well was drilled under my jurisdiction and this report is true to the best of my knowledge and belief. Rothroe Pump & Well 295 Business name License No. Address 827 W 27th St. Signed JP Rothroe Date 7-22-76 Authorized representative		

Forward the white, blue and pink copies to the Department of Health and Environment

Form WWC-5