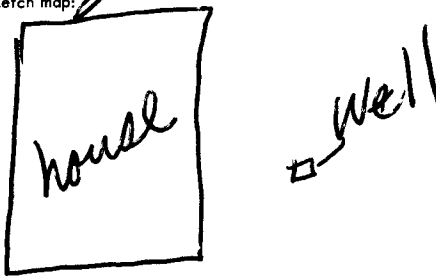


USE TYPEWRITER OR BALL
POINT PEN-PRESS FIRMLY,
PRINT CLEARLY.

WATER WELL RECORD
KSA 82a-1201-1215

Kansas Department of Health and
Environment-Division of Environment
(Water well Contractors)
Topeka, Kansas 66620

1. Location of well:		County <u>Sedgwick</u>	Fraction <u>NE 1/4 NE 1/4 SE 1/4</u>	Section number <u>19</u>	Township number <u>T 26 S</u>	Range number <u>R 1 E</u>
2. Distance and direction from nearest town or city:		3. Owner of well: <u>Kathryn Barnett</u>		R.R. or street: <u>5431 Paula</u>		
Street address of well location if in city: <u>319 Jonathan Maize KS</u>		City, state, zip code: <u>Wichita KS 67212</u>				
4. Locate with "X" in section below:		Sketch map:		6. Bore hole <u>1 1/2</u> in. Completion date <u>3/23/78</u>		
N 1 Mile W E S 1 Mile				Well depth <u>52</u> ft.		
5. Type and color of material		From		To		7. ☒ Cable tool ☒ Rotary ☐ Driven ☐ Dug ☐ Hollow rod ☐ Jetted ☐ Bored ☐ Reverse rotary
Top soil		0		4		8. Use: ☒ Domestic ☐ Public supply ☐ Industry ☐ Irrigation ☐ Air conditioning ☐ Stock ☐ Lawn ☐ Oil field water ☐ Other
Red clay		4		18		9. Casing: Material <u>PVC</u> Height <u>Above</u> or below
fine sand		18		28		Threading <u>Welded</u> ☒ Surface <u>1 1/2</u> in.
Red clay		28		30		RMP <u>PVC</u> ☒ Weight <u>2.76</u> lbs./ft.
med. to coarse gravel		30		52		Dia. <u>5</u> in. to <u>52</u> ft. depth Wall Thickness: inches <u>1/2</u>
Red clay		52				Dia. <u>5</u> in. to <u>52</u> ft. depth gage No. <u>258</u>
						10. Screen: Manufacturer's name <u>M.P.I.</u>
						Type <u>Sch 40</u> Dia. <u>5</u> in.
						Not gauze <u>1 1/2</u> Length <u>10</u> ft.
						Set between <u>1 1/2</u> ft. and <u>5</u> ft.
						Gravel pack? <u>yes</u> size range of material <u>3/8</u>
						11. Static water level: <u>23</u> ft. below land surface Date <u>3/23/78</u>
						12. Pumping level below land surfaces:
						<u>24</u> ft. after <u>1/2</u> hrs. pumping <u>20</u> g.p.m.
						<u>24</u> ft. after <u>1/2</u> hrs. pumping <u>20</u> g.p.m.
						Estimated maximum yield <u>75</u> g.p.m.
						13. Water sample submitted: <u>Yes</u> ☒ No ☐ Date <u>3/23/78</u>
						14. Well head completion: <u>12</u> inches above grade
						☒ Pitless adapter <u>12</u> inches above grade
						15. Well grouted? <u>yes</u>
						With: <u>Neat cement</u> ☐ Bentonite ☒ Concrete ☐
						Depth: From <u>3</u> ft. to <u>13</u> ft.
						16. Nearest source of possible contamination: <u>None</u>
						ft. <u>None</u> Direction <u>None</u> Type <u>None</u>
						Well disinfected upon completion? ☒ Yes ☐ No
						17. Pump: <u>Not installed</u>
						Manufacturer's name <u>FFW</u>
						Model number <u>10518</u> HP <u>1/2</u> Vol. <u>220</u>
						Length of drop pipe <u>30</u> ft. capacity <u>10</u> g.p.m.
						Type: ☒ Submersible ☐ Turbine
						☐ Jet ☐ Reciprocating
						☐ Centrifugal ☐ Other
18. Elevation:		19. Remarks:		20. Water well contractor's certification:		
Topography: ☐ Hill ☒ Slope ☐ Upland ☐ Valley		Customer to furnish 4x4x4 slab around casing as per state regulations Signed <u>X Kathryn Barnett</u>		This well was drilled under my jurisdiction and this report is true to the best of my knowledge and belief. 

Forward the white, blue and pink copies to the Department of Health and Environment

Form WWC-5