USE TYPEWRITER OR BALL POINT PEN-PRESS FIRMLY, PRINT CLEARLY.

WATER WELL RECORD
KSA 82a-1201-1215

Kansas Department of Health and Environment-Division of Environment
(Water well Contractors)
Topeka, Kansas 66620

1. Location of well:	County	Fraction	Section number	Township number	Range number
	Sedgwick	SE 1/4 SW 1/4 SE 1/4	19	T 26 S	R 1W E/W

2. Distance and direction from nearest town or city:
Street address of well location if in city: 610 James, Maize, Kansas

3. Owner of well: Don Sones Construction
R.R. or street: 541 Trotter
City, state, zip code: Maize, Kansas

4. Locate with "X" in section below:

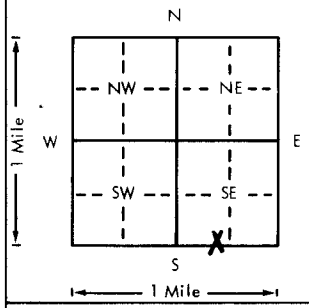

Sketch map:

6. Bore hole dia. 11 in. Completion date
Well depth 45 ft. 10-30-78

7. __ Cable tool X Rotary __ Driven __ Dug
__ Hollow rod __ Jetted __ Bored __ Reverse rotary

8. Use: X Domestic __ Public supply __ Industry
__ Irrigation __ Air conditioning __ Stock
__ Lawn __ Oil field water __ Other

9. Casing: Material Styrene Height: Above or below ///
Threaded __ Welded gl Surface 12 in.
RMP X PVC __ Weight __ lbs./ft.
Dia. 5 in. to 45 ft. depth Wall Thickness: inches or
Dia. __ in. to __ ft. depth gage No. .200

5. Type and color of material	From	To
Topsoil	0	3
Clay	3	10
Fine sand	10	25
Medium sand	25	45
(Use a second sheet if needed)		

10. Screen: Manufacturer's name Sunflower plastic
Type styrene Dia. 5"
Slot/gauze .06 Length 20'
Set between 25 ft. and 45 ft.
ft. and ft.
Gravel pock? yes Size ronge of material 1/8-1"

11. Static water level: mo./day/yr.
16 ft. below land surface Date 10-30-78

12. Pumping level below land surfaces:
ft. after hrs. pumping g.p.m.
ft. after hrs. pumping g.p.m.
Estimated maximum yield g.p.m.

13. Water sample submitted: mo./doy/yr.
__ Yes __ No Date

14. Well head completion: capped
__ Pitless adapter 12 Inches above grade

15. Well grouted? yes 1-2fine sand mix
With: __ Neat cement __ Bentonite X Concrete
Depth: From 6 ft. to 16 ft.

16. Nearest source of possible contamination:
ft. Direction Type None
Well disinfected upon completion? X Yes __ No

17. Pump: X Not installed
Manufacturer's name
Model number HP Volts
Length of drop pipe ft. capacity g.p.m.
Type:
__ Submersible __ Turbine
__ Jet __ Reciprocating
__ Centrifugal __ Other

18. Elevation:

Topography:
__ Hill
__ Slope
__ Upland
__ Valley

19. Remarks:

Flat ground
Septic system not installed at this time
No apparent source for contamination
Well is to be in the basement.

20. Water well contractor's certification:
This well was drilled under my jurisdiction and this report is true to the best of my knowledge and belief.
Harp Well & Pump 236
Business name License No.
Address Wichita, Kansas 67209
Signed M. Arnold Date
(Authorized representative) 11-30-78

T 26 R 1W E Sec 19 1/4 1/4 1/4 SWSE

Forward the white, blue and pink copies to the Department of Health and Environment

Form WWC-5

MI-1023