USE TYPEWRITER OR BALL POINT PEN-PRESS FIRMLY, PRINT CLEARLY.

WATER WELL RECORD
KSA 82a-1201-1215

Kansas Department of Health and Environment-Division of Environment
(Water well Contractors)
Topeka, Kansas 66620

1. Location of well: County: Sedgwick | Fraction: NE 1/4 SW 1/4 NE 1/4 | Section number: 19 [redacted] | Township number: T 26S | Range number: R 1 E/W

2. Distance and direction from nearest town or city: 620 Queen
Street address of well location if in city: Maize, Kans.

3. Owner of well: Diane Chrisenberry
R.R. or street: 620 Queen
City, state, zip code: Maize, Kansas

4. Locate with "X" in section below: Sketch map:

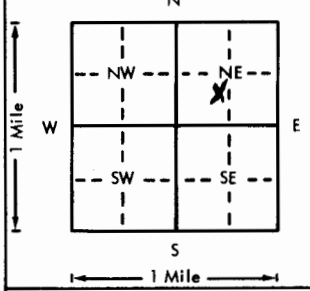

6. Bore hole dia. 11 in. Completion date 5-10-76
Well depth 60 ft.

7. ___ Cable tool ✓ Rotary ___ Driven ___ Dug
___ Hollow rod ___ Jetted ___ Bored ___ Reverse rotary

8. Use: ✓ Domestic ___ Public supply ___ Industry
___ Irrigation ___ Air conditioning ___ Stock
___ Lawn ___ Oil field water ___ Other

9. Casing: Material STYRENE Height: Above or below
Threaded ___ Welded GL Surface 12 in.
RMP ✓ PVC ___ Weight ___ lbs./ft.
Dia. 5 in. to 60 ft. depth Wall Thickness: inches or
Dia. ___ in. to ___ ft. depth gage No. 200

5. Type and color of material	From	To
Sandy Topsoil	0	3
Clay	3	13
Fine Sand	13	30
Medium Sand	30	52
Clay	52	60
(Use a second sheet if needed)		

10. Screen: Manufacturer's name SUNFLOWER PLASTIC
Type STYRENE Dia. 5"
Slot/gauze 006 Length 20'
Set between 40 ft. and 60 ft.
___ ft. and ___ ft.
Gravel pack? YES Size range of material 1/4-1 1/8"

11. Static water level: mo./day/yr.
18 ft. below land surface Date 5-10-76

12. Pumping level below land surfaces:
___ ft. after ___ hrs. pumping ___ g.p.m.
___ ft. after ___ hrs. pumping ___ g.p.m.
Estimated maximum yield ___ g.p.m.

13. Water sample submitted: mo./day/yr.
___ Yes ___ No Date ___

14. Well head completion: Capped
___ Pitless adapter 12 Inches above grade

15. Well grouted? YES
With: ___ Neat cement ___ Bentonite ✓ Concrete
Depth: From 40' to 14 ft.

16. Nearest source of possible contamination:
ft. 55 Direction SO Type Septic Line
Well disinfected upon completion? ✓ Yes ___ No

17. Pump: ✓ Not installed
Manufacturer's name ___
Model number ___ HP ___ Volts ___
Length of drop pipe ___ ft. capacity ___ g.p.m.
Type:
___ Submersible ___ Turbine
___ Jet ___ Reciprocating
___ Centrifugal ___ Other

18. Elevation:
Topography:
___ Hill
✓ Slope
___ Upland
___ Valley

19. Remarks:
Pump not installed.

20. Water well contractor's certification:
This well was drilled under my jurisdiction and this report is true to the best of my knowledge and belief.
HARPWELL + PUMP 236
Business name License No.
Address WICHITA, KANSAS
Signed M. Arnold Date 7-30-76
Authorized representative

T 26 R 1 E/W Sec 19 1/4 1/4 1/4 SWNE

Forward the white, blue and pink copies to the Department of Health and Environment

Form WWC-5

MI-1023