


LOCATION OF WATER WELL: Fraction NE 1/4 SW 1/4 SE 1/4 Section Number 19 Township Number T 26 S Range Number R 1 E
 County: SEDGWICK
 Distance and direction from nearest town or city street address of well if located within city?

831 TROMER-MAZZE

WATER WELL OWNER: TIMMETHERRY
 RR#, St. Address, Box #: 831 TROMER
 City, State, ZIP Code: MAZZE, KS. 67101
 Board of Agriculture, Division of Water Resources
 Application Number:

LOCATE WELL'S LOCATION WITH AN "X" IN SECTION BOX:

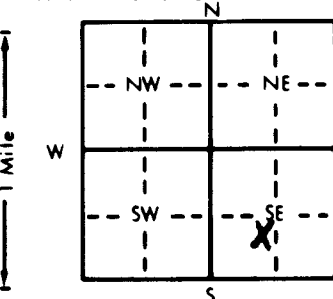

DEPTH OF COMPLETED WELL: 61 ft. ELEVATION:

Depth(s) Groundwater Encountered 1. 24 ft. 2. 24 ft. 3. 24 ft.

WELL'S STATIC WATER LEVEL 24 ft. below land surface measured on mo/day/yr 9-10-87

Pump test data: Well water was 24 ft. after 2 hours pumping 20 gpm

Est. Yield 15 gpm: Well water was 24 ft. after 2 hours pumping 20 gpm

Bore Hole Diameter: 11 in. to 61 ft., and 61 in. to 61 ft.

WELL WATER TO BE USED AS:

1 Domestic 3 Feedlot 6 Oil field water supply 9 Dewatering 12 Other (Specify below)

2 Irrigation 4 Industrial 7 Lawn and garden only 10 Observation well

Was a chemical/bacteriological sample submitted to Department? Yes X No X; If yes, mo/day/yr sample was submitted

Water Well Disinfected? Yes X No X

TYPE OF BLANK CASING USED:

1 Steel 3 RMP (SR) 5 Wrought iron 8 Concrete tile CASING JOINTS: Glued X Clamped

2 PVC 4 ABS 6 Asbestos-Cement 9 Other (specify below) Welded

Blank casing diameter 5 in. to 5 ft., Dia. 5 in. to 5 ft., Dia. 5 in. to 5 ft.

Casing height above land surface 12 in., weight 1.59 lbs./ft. Wall thickness or gauge No. SPR-26

TYPE OF SCREEN OR PERFORATION MATERIAL:

1 Steel 3 Stainless steel 5 Fiberglass 8 RMP (SR) 11 Other (specify)

2 Brass 4 Galvanized steel 6 Concrete tile 9 ABS 12 None used (open hole)

SCREEN OR PERFORATION OPENINGS ARE:

1 Continuous slot 3 Mill slot 5 Gauzed wrapped 8 Saw cut 11 None (open hole)

2 Louvered shutter 4 Key punched 6 Wire wrapped 9 Drilled holes

SCREEN-PERFORATED INTERVALS: From 51 ft. to 61 ft., From 51 ft. to 61 ft.


GRAVEL PACK INTERVALS: From 23 ft. to 61 ft., From 23 ft. to 61 ft.


GROUT MATERIAL:

1 Neat cement 2 Cement grout 3 Bentonite 4 Other

Grout intervals: From 3 ft. to 23 ft., From 23 ft. to 61 ft., From 23 ft. to 61 ft.

What is the nearest source of possible contamination:

1 Septic tank 4 Lateral lines 7 Pit privy 10 Livestock pens 14 Abandoned water well

2 Sewer lines 5 Cess pool 8 Sewage lagoon 11 Fuel storage 15 Oil well/Gas well

3 Watertight sewer lines 6 Seepage pit 9 Feedyard 12 Fertilizer storage 16 Other (specify below)

13 Insecticide storage

Direction from well? West How many feet? 55

FROM	TO	LITHOLOGIC LOG	FROM	TO	LITHOLOGIC LOG
0	2	Top so.			
2	19	clay			
19	33	fine sand			
33	34	clay			
34	61	Med to coarse gravel			

CONTRACTOR'S OR LANDOWNER'S CERTIFICATION: This water well was (1) constructed (2) reconstructed, or (3) plugged under my jurisdiction and was

completed on (mo/day/year) 9-10-87 and this record is true to the best of my knowledge and belief, Kansas

Water Well Contractor's License No. 318 This Water Well Record was completed on (mo/day/yr) SEP 10 1987

under the business name of WEDDINGER DRILLING by (signature) Jerome Weddinger

INSTRUCTIONS: Use typewriter or ball point pen. PLEASE PRESS FIRMLY and PRINT clearly. Please fill in blanks, underline or circle the correct answers. Send top three copies to Kansas

Department of Health and Environment, Bureau of Water Protection, Topeka, Kansas 66620-7320, Telephone: 913-862-9360. Send one to WATER WELL OWNER and retain one for your records.

OFFICE USE ONLY

T

R

E/W

SEC.

1/4

1/4

1/4