


1 LOCATION OF WATER WELL: Fraction SE 1/4 NE 1/4 SE 1/4 Section Number 19 Township Number T 26 S Range Number R 1 E
 County: SEDGWICK
 Distance and direction from nearest town or city street address of well if located within city?

4715 NEADRYX - MARZE, KS

2 WATER WELL OWNER: BUD ALDERSON
 RR#, St. Address, Box #: 1447 WESTGATE
 City, State, ZIP Code: WICHITA, KS 67212
 Board of Agriculture, Division of Water Resources
 Application Number:

3 LOCATE WELL'S LOCATION WITH AN "X" IN SECTION BOX:

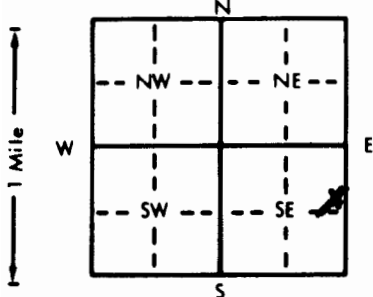

4 DEPTH OF COMPLETED WELL: 50 ft. ELEVATION:

Depth(s) Groundwater Encountered 1. 24 ft. 2. 24 ft. 3. 24 ft.

WELL'S STATIC WATER LEVEL 24 ft. below land surface measured on mo/day/yr 6-5-87

Pump test data: Well water was 24 ft. after 1 hours pumping 20 gpm

Est. Yield 50 gpm: Well water was 24 ft. after 1 hours pumping 20 gpm

Bore Hole Diameter 11 in. to 50 ft. and 50 in. to 50 ft.

WELL WATER TO BE USED AS: 5 Public water supply 8 Air conditioning 11 Injection well

1 Domestic 3 Feedlot 6 Oil field water supply 9 Dewatering 12 Other (Specify below)

2 Irrigation 4 Industrial 7 Lawn and garden only 10 Observation well

Was a chemical/bacteriological sample submitted to Department? Yes No If yes, mo/day/yr sample was submitted

Water Well Disinfected? Yes X No

5 TYPE OF BLANK CASING USED: 1 Steel 3 RMP (SR) 5 Wrought iron 8 Concrete tile CASING JOINTS: Glued X Clamped

2 PVC 4 ABS 6 Asbestos-Cement 9 Other (specify below) Welded

Blank casing diameter 5 in. to 38 ft. Dia. 12 in. to 159 lbs./ft. Wall thickness or gauge No. DR-26

Casing height above land surface 12 in. weight 159 lbs./ft. Wall thickness or gauge No. DR-26

TYPE OF SCREEN OR PERFORATION MATERIAL: 1 Steel 3 Stainless steel 5 Fiberglass 8 RMP (SR) 10 Asbestos-cement

2 Brass 4 Galvanized steel 6 Concrete tile 9 ABS 11 Other (specify)

SCREEN OR PERFORATION OPENINGS ARE: 1 Continuous slot 3 Mill slot 5 Gauzed wrapped 8 Saw cut 11 None (open hole)

2 Louvered shutter 4 Key punched 6 Wire wrapped 9 Drilled holes 10 Other (specify)

SCREEN-PERFORATED INTERVALS: From 38 ft. to 50 ft. From 38 ft. to 50 ft.

GRAVEL PACK INTERVALS: From 23 ft. to 50 ft. From 23 ft. to 50 ft.

6 GROUT MATERIAL: 1 Neat cement 2 Cement grout 3 Bentonite 4 Other

Grout Intervals: From 3 ft. to 23 ft. From 3 ft. to 23 ft.

What is the nearest source of possible contamination: 1 Septic tank 4 Lateral lines 7 Pit privy 10 Livestock pens 14 Abandoned water well

2 Sewer lines 5 Cess pool 8 Sewage lagoon 11 Fuel storage 15 Oil well/Gas well

3 Watertight sewer lines 6 Seepage pit 9 Feedyard 12 Fertilizer storage 16 Other (specify below)

Direction from well? 13 How many feet? South

FROM TO LITHOLOGIC LOG FROM TO LITHOLOGIC LOG

0 2 Top Soil

2 18 Clay

18 34 Sand

34 35 Clay

35 50 Gravel

7 CONTRACTOR'S OR LANDOWNER'S CERTIFICATION: This water well was (1) constructed, (2) reconstructed, or (3) plugged under my jurisdiction and was completed on (mo/day/year) 6-5-87 and this record is true to the best of my knowledge and belief. Kansas

Water Well Contractor's License No. 318 This Water Well Record was completed on (mo/day/yr) 6-5-87

under the business name of Wenger Pumping by (signature) Wenger

INSTRUCTIONS: Use typewriter or ball point pen, PLEASE PRESS FIRMLY and PRINT clearly. Please fill in blanks, underline or circle the correct answers. Send top three copies to Kansas

Department of Health and Environment, Office of Oil Field and Environmental Geology, Regulation and Permitting Section, Topeka, Kansas 66620-7500, telephone: 913-862-9360. Send one to WATER WELL OWNER and retain one for your records.

OFFICE USE ONLY

T

R

EW

SEC.

1/4

1/4

1/4