

1 LOCATION OF WATER WELL: Fraction SW 1/4 NE 1/4 NE 1/4 Section Number 19 Township Number T 26 S Range Number R 1 E
 County: Sedgwick
 Distance and direction from nearest town or city street address of well if located within city?

See Below

2 WATER WELL OWNER:

RR#, St. Address, Box #:

City, State, ZIP Code:


JEFF PROTROWSKI
217 Queen
M4IZE KS 67101

Board of Agriculture, Division of Water Resources

Application Number:

3 LOCATE WELL'S LOCATION WITH AN "X" IN SECTION BOX:

4 DEPTH OF COMPLETED WELL: 36 ft. ELEVATION:

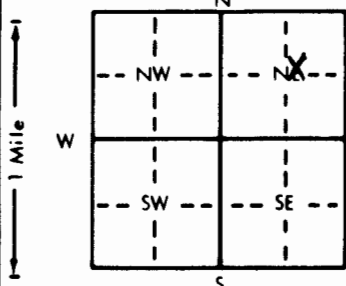

Depth(s) Groundwater Encountered 1. 11 ft. 2. 11 ft. 3. 11 ft.
 WELL'S STATIC WATER LEVEL 11 ft. below land surface measured on mo/day/yr 1-25-89

Pump test data: Well water was 11 ft. after 1/2 hours pumping 20 gpm

Est. Yield 50 gpm: Well water was 11 ft. after 1/2 hours pumping 20 gpm

Bore Hole Diameter 11 in. to 36 ft., and 11 in. to 36 ft.

WELL WATER TO BE USED AS: 5 Public water supply 8 Air conditioning 11 Injection well

1 Domestic 3 Feedlot 6 Oil field water supply 9 Dewatering 12 Other (Specify below)

2 Irrigation 4 Industrial 7 Lawn and garden only 10 Monitoring well

Was a chemical/bacteriological sample submitted to Department? Yes X No X If yes, mo/day/yr sample was submitted

Water Well Disinfected? Yes X No X

5 TYPE OF BLANK CASING USED:

1 Steel

3 RMP (SR)

5 Wrought iron

8 Concrete tile

CASING JOINTS: Glued X Clamped

2 PVC

4 ABS

6 Asbestos-Cement

9 Other (specify below)

Welded

7 Fiberglass

Threaded

Blank casing diameter 5 in. to 26 ft., Dia 5 in. to 26 ft., Dia 5 in. to 26 ft.

Casing height above land surface 12 in., weight 1159 lbs./ft. Wall thickness or gauge No SDR-26

TYPE OF SCREEN OR PERFORATION MATERIAL:

1 Steel

3 Stainless steel

5 Fiberglass

7 PVC

10 Asbestos-cement

2 Brass

4 Galvanized steel

6 Concrete tile

8 RMP (SR)

11 Other (specify)

9 ABS

12 None used (open hole)

SCREEN OR PERFORATION OPENINGS ARE:

1 Continuous slot

3 Mill slot

5 Gauzed wrapped

8 Saw cut

11 None (open hole)

2 Louvered shutter

4 Key punched

6 Wire wrapped

9 Drilled holes

7 Torch cut

10 Other (specify)

SCREEN-PERFORATED INTERVALS: From 26 ft. to 36 ft., From 26 ft. to 36 ft., From 26 ft. to 36 ft.

GRAVEL PACK INTERVALS: From 12 ft. to 36 ft., From 12 ft. to 36 ft., From 12 ft. to 36 ft.

6 GROUT MATERIAL:

1 Neat cement

2 Cement grout

3 Bentonite

4 Other

Grout Intervals: From 3 ft. to 12 ft., From 3 ft. to 12 ft., From 3 ft. to 12 ft.

What is the nearest source of possible contamination:

1 Septic tank

4 Lateral lines

7 Pit privy

10 Livestock pens

14 Abandoned water well

2 Sewer lines

5 Cess pool

8 Sewage lagoon

11 Fuel storage

15 Oil well/Gas well

3 Watertight sewer lines

6 Seepage pit

9 Feedyard

12 Fertilizer storage

16 Other (specify below)

13 Insecticide storage

Direction from well?

North

How many feet? 20

FROM	TO	LITHOLOGIC LOG	FROM	TO	PLUGGING INTERVALS
0	2	top so.			
2	12	clay.			
12	21	fine sand			
21	22	clay			
22	36	gravel			

7 CONTRACTOR'S OR LANDOWNER'S CERTIFICATION: This water well was (1) constructed, (2) reconstructed, or (3) plugged under my jurisdiction and was completed on (mo/day/year) 1-25-89 and this record is true to the best of my knowledge and belief. Kansas

Water Well Contractor's License No. 318 This Water Well Record was completed on (mo/day/yr) 1-30-89

under the business name of Weninger Dilling by (signature) [Signature]