

SW SE NW NE

WATER WELL RECORD

Form WWC-5

KSA 82a-1212

LOCATION OF WATER WELL: County: <u>Sedgwick</u>	Fraction: <u>SW 1/4</u>	Section Number: <u>19</u>	Township Number: <u>T 26 S</u>	Range Number: <u>R 1 W</u>
--	-------------------------	---------------------------	--------------------------------	----------------------------

Distance and direction from nearest town or city street address of well if located within city?

WATER WELL OWNER:

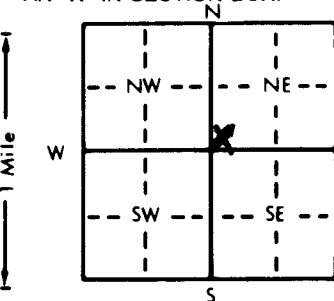
RR#, St. Address, Box #

City, State, ZIP Code

Board of Agriculture, Division of Water Resources

Application Number:

LOCATE WELL'S LOCATION WITH AN "X" IN SECTION BOX:

DEPTH OF COMPLETED WELL: 36 ft. ELEVATION:Depth(s) Groundwater Encountered 1. 14 ft. 2. 14 ft. 3. 14 ft.WELL'S STATIC WATER LEVEL 14 ft. below land surface measured on mo/day/yr 12-9-89Pump test data: Well water was 14 ft. after 20 hours pumping 75 gpmEst. Yield 75 gpm: Well water was 14 ft. after 20 hours pumping 75 gpmBore Hole Diameter 11 in. to 36 ft., and 36 in. to 36 ft.

WELL WATER TO BE USED AS:

- | | | | | |
|--|---------------------------------------|---|---|---|
| ☒ 1 Domestic | ☐ 3 Feedlot | ☐ 6 Oil field water supply | ☐ 9 Dewatering | ☐ 11 Injection well |
| ☐ 2 Irrigation | ☐ 4 Industrial | ☐ 7 Lawn and garden only | ☐ 10 Monitoring well | ☐ 12 Other (Specify below) |

Was a chemical/bacteriological sample submitted to Department? Yes X No X; If yes, mo/day/yr sample was submittedWater Well Disinfected? Yes X No X

TYPE OF BLANK CASING USED:

- | | |
|----------------------------------|--|
| ☐ 1 Steel | ☒ 3 RMP (SR) |
| ☐ 2 PVC | ☐ 4 ABS |

- | | |
|---|--|
| ☐ 5 Wrought iron | ☐ 6 Asbestos-Cement |
| ☐ 7 Fiberglass | ☐ 8 Concrete tile |

- | | |
|--|---|
| ☐ 9 Other (specify below) | ☐ 10 Asbestos-cement |
| ☐ 11 Other (specify) | ☐ 12 None used (open hole) |

- | | |
|--|-----------------------------------|
| ☒ CASING JOINTS: Glued | ☐ Clamped |
| ☐ Welded | ☐ Threaded |

Blank casing diameter 5 in. to 27 ft., Dia. 1.59 in. to 5 ft., Dia. 5 in. to 26 ft.Casing height above land surface 12 in., weight 1.59 lbs./ft. Wall thickness or gauge No. 5

TYPE OF SCREEN OR PERFORATION MATERIAL:

- | | |
|----------------------------------|---|
| ☐ 1 Steel | ☐ 3 Stainless steel |
| ☐ 2 Brass | ☐ 4 Galvanized steel |

- | | |
|--|--|
| ☐ 5 Fiberglass | ☒ 6 RMP (SR) |
| ☐ 6 Concrete tile | ☐ 9 ABS |

- | | |
|---|---|
| ☐ 7 PVC | ☐ 10 Asbestos-cement |
| ☐ 11 Other (specify) | ☐ 12 None used (open hole) |

SCREEN OR PERFORATION OPENINGS ARE:

- | | |
|---|---|
| ☐ 1 Continuous slot | ☒ 3 Mill slot |
| ☐ 2 Louvered shutter | ☐ 4 Key punched |

- | | |
|---|--|
| ☐ 5 Gauzed wrapped | ☐ 8 Saw cut |
| ☐ 6 Wire wrapped | ☐ 9 Drilled holes |

- | | |
|--|---|
| ☐ 7 Torch cut | ☐ 10 Other (specify) |
| ☐ 11 None (open hole) | |

SCREEN-PERFORATED INTERVALS: From 27 ft. to 36 ft., From 27 ft. to 36 ft., From 27 ft. to 36 ft.GRAVEL PACK INTERVALS: From 20 ft. to 36 ft., From 20 ft. to 36 ft., From 20 ft. to 36 ft.

GROUT MATERIAL:

- | | |
|--|--|
| ☐ 1 Neat cement | ☒ 2 Cement grout |
| ☐ 3 Bentonite | ☐ 4 Other |

Grout intervals: From 3 ft. to 20 ft., From 3 ft. to 20 ft., From 3 ft. to 20 ft.

What is the nearest source of possible contamination:

- | | | |
|--|--|--|
| ☐ 1 Septic tank | ☐ 4 Lateral lines | ☐ 7 Pit privy |
| ☐ 2 Sewer lines | ☐ 5 Cess pool | ☐ 8 Sewage lagoon |
| ☒ 3 Watertight sewer lines | ☐ 6 Seepage pit | ☐ 9 Feedyard |

- | | |
|---|---|
| ☐ 10 Livestock pens | ☐ 14 Abandoned water well |
| ☐ 11 Fuel storage | ☐ 15 Oil well/Gas well |
| ☐ 12 Fertilizer storage | ☐ 16 Other (specify below) |
| ☐ 13 Insecticide storage | |

Direction from well?

West.How many feet? 35

FROM	TO	LITHOLOGIC LOG	FROM	TO	PLUGGING INTERVALS
0	2	Top soil			
2	12	Clay			
12	20	fine sand.			
20	21	clay			
21	36	gravel			

CONTRACTOR'S OR LANDOWNER'S CERTIFICATION: This water well was (1) constructed, (2) reconstructed, or (3) plugged under my jurisdiction and was completed on (mo/day/year) 12-9-89 and this record is true to the best of my knowledge and belief. KansasWater Well Contractor's License No. 318 This Water Well Record was completed on (mo/day/yr) 12-11-89 under the business name of Wenger Dull by (signature) Wenger

INSTRUCTIONS: Use typewriter or ball point pen. PLEASE PRESS FIRMLY and PRINT clearly. Please fill in blanks, underline or circle the correct answers. Send top three copies to Kansas Department of Health and Environment, Bureau of Water Protection, Topeka, Kansas 66620-7320. Telephone: 913-296-5514. Send one to WATER WELL OWNER and retain one for your records.