USE TYPEWRITER OR BALL POINT PEN-PRESS FIRMLY, PRINT CLEARLY.

T R EW sec 1/4 1/4 1/4 No.

WATER WELL RECORD
KSA 82a-1201-1215

NW 1/4
SW 1/4

Kansas State Dept. Of Health
(Water Well Contractors)
Forbes-Bldg. 740
Topeka, Kansas 66620

1 Location of well: County: Sedg | Township name: PARK | Fraction: SW 1/4 | Section number: 20 | Town number: 26S | Range number: 1W.

Distance and direction from nearest town or city: 1/2 mile So of MAIZE KS

Street address of well location if in city:

3 Owner of well: DAVE Ridder
Address: 4908 W. 1st. Wichita KS

Locate with "X" in section below:

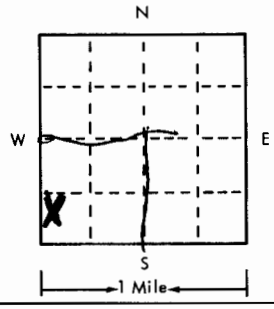

Sketch map: New home well in basement.

4 Well depth: 50 ft. Date of completion 5/20
Well diameter 5 in.

5 ☐ Cable tool ☑ Rotary ☐ Driven ☐ Dug ☐ Hollow rod ☐ Jetted ☐ Bored ☐ Reverse rotary

6 Use: ☑ Domestic ☐ Public supply ☐ Industry ☐ Irrigation ☐ Air conditioning ☐ Commercial ☐ Test well ☐

7 Casing: Material: plastic Height: above/below
Threaded ☐ Welded ☑ Surface 18 in.
Diam. 5 in. to 50 ft. depth Weight 1.50 lbs./ft. 100
___ in. to ___ ft. depth Drive shoe? ☐ Yes ☑ No

2 Type and color of material	From	To
Top Soil	0	8
fine to course gravel	8	50

8 Screen:
Manufacturer Jesco & Lowell
Type plastic Dia. 5
Slot/gauze ___ Length 10
Set between 40 ft. and 50 ft.
Fittings:
Gravel pack ☑ Yes ☐ No Size range of material 3/8

9 Static water level:
15 ft. below land surface Date 5/20

10 Pumping level below land surface:
___ ft. after ___ hrs. pumping ___ g.p.m.
___ ft. after ___ hrs. pumping ___ g.p.m.
Estimated maximum yield 100 g.p.m.

11 Water sample submitted:
☐ Yes ☑ No Date ___

12 Well head completion:
☐ Pitless adapter ☑ 18 inches above grade

13 Well grouted? ☑ Yes ☐ No
☑ Neat cement ☐ Bentonite ☐ ___
Depth: From 3 ft. to 23 ft.

14 Nearest source of possible contamination:
ft. ___ Direction NONE Type ___
Well disinfected upon completion? ☑ Yes ☐ No

15 Pump: ☑ Not installed
Manufacturer's name ___
Model number ___ HP ___ Volts ___
Length of drop pipe ___ ft. capacity ___ g.m.p.
Type:
☐ Submersible ☐ Turbine
☐ Jet ☐ Reciprocating
☐ Certrifugal ☐ Other

(use a second sheet if needed)

16 Remarks: elevation

Topography:
☐ Hill
☐ Slope
☑ Upland
☐ Valley

upland.

17 Water well contractor's certification:
This well was drilled under my jurisdiction and this report is true to the best of my knowledge and belief.
WENINGER Pez 1238A
Business name License No.
Address MAIZE KS
Signed Authorized representative Date 5/20

Forward the white, blue and pink copies to the Kansas State Dept. Of Health.

Form WWC-5

677-H