USE TYPEWRITER OR BALL POINT PEN-PRESS FIRMLY, PRINT CLEARLY.

WATER WELL RECORD
KSA 82a-1201-1215

Kansas Department of Health and Environment-Division of Environment
(Water well Contractors)
Topeka, Kansas 66620

1. Location of well: County: Sedgwick | Fraction: NW 1/4 NW 1/4 SW 1/4 | Section number: 22 | Township number: T 26S | Range number: R 1 E/W

2. Distance and direction from nearest town or city: SE corner of Ridge Road & 47th St No.
Street address of well location if in city:

3. Owner of well: Dick Draghard
R.R. or street: 6726 Ocio
City, state, zip code: Wichita, Kansas

4. Locate with "X" in section below:

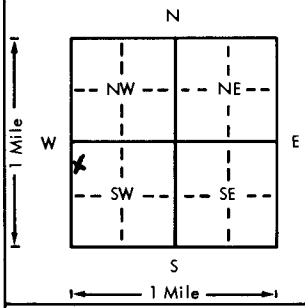

Sketch map: on the South Side Wichita, Kansas

6. Bore hole dia. 11 in. Completion date
Well depth 38 ft. 6-11-76

7. Cable tool ✓ Rotary Driven Dug
Hollow rod Jetted Bored Reverse rotary

8. Use: ✓ Domestic Public supply Industry
Irrigation Air conditioning Stock
Lawn Oil field water Other

9. Casing: Material STYRENE Height: (Above) or below
Threaded Welded GL Surface 12 in.
RMP ✓ PVC Weight lbs./ft.
Dia. 5 in. to 38 ft. depth Wall Thickness: inches or
Dia. in. to ft. depth gage No. 1200

5. Type and color of material	From	To
Topsoil	0	3
Fine Sand	3	15
Medium Sand	15	38

(Use a second sheet if needed)

10. Screen: Manufacturer's name SUNFLOWER PLASTIC
Type STYRENE Dia. 5"
Slot/gauze .06 Length 10 ft
Set between 28 ft. and 38 ft.
ft. and ft.
Gravel pack? YES Size range of material 1/4 - 1/8"

11. Static water level: mo./day/yr.
15 ft. below land surface Date 6-11-76

12. Pumping level below land surfaces:
ft. after hrs. pumping g.p.m.
ft. after hrs. pumping g.p.m.
Estimated maximum yield g.p.m.

13. Water sample submitted: mo./day/yr.
Yes No Date

14. Well head completion: Capped
Pitless adapter 12 Inches above grade

15. Well grouted? YES
With: Neat cement Bentonite ✓ Concrete
Depth: From 40' to 14 ft.

16. Nearest source of possible contamination: Septic
ft. 60 Direction SE Type Tank
Well disinfected upon completion? ✓ Yes No

17. Pump: ✓ Not installed
Manufacturer's name
Model number HP Volts
Length of drop pipe ft. capacity g.p.m.
Type:
Submersible Turbine
Jet Reciprocating
Centrifugal Other

18. Elevation:
Topography:
Hill
Slope
Upland
Valley

19. Remarks: Flat Ground
Pump not installed at this time.

20. Water well contractor's certification:
This well was drilled under my jurisdiction and this report is true to the best of my knowledge and belief.
HARP WELL + PUMP 236
Business name License No.
Address WICHITA, KANSAS
Signed M. Arnold Date
Authorized representative 8-12-76

T 26 R 1 W Sec 22 1/4 1/4 1/4 SW

Forward the white, blue and pink copies to the Department of Health and Environment

Form WWC-5

MI-1023