

1 LOCATION OF WATER WELL	Fraction	Section Number	Township Number	Range Number
County: <u>Sedgwick</u>	<u>SE 1/4 NW 1/4 SW 1/4</u>	<u>22</u>	T <u>26</u> S	R <u>1</u> EW

Distance and direction from nearest town or city street address of well if located within city?

See Below

2 WATER WELL OWNER:

RR#, St. Address, Box # :

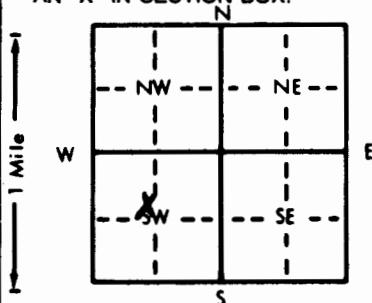
City, State, ZIP Code :

Henry Kane
6915 Osceola
Wichita KS 67204

Board of Agriculture, Division of Water Resources

Application Number:

3 LOCATE WELL'S LOCATION WITH AN "X" IN SECTION BOX:


WELL WATER TO BE USED AS:

☒ 1 Domestic	☐ 3 Feedlot	☐ 6 Oil field water supply	☐ 9 Dewatering	☐ 12 Other (Specify below)
☐ 2 Irrigation	☐ 4 Industrial	☐ 7 Lawn and garden only	☐ 10 Observation well	

Was a chemical/bacteriological sample submitted to Department? Yes X No ; If yes, mo/day/yr sample was submittedWater Well Disinfected? Yes X No

5 TYPE OF BLANK CASING USED:

- 1 Steel
 2 PVC
3 RMP (SR)
 4 ABS

- 5 Wrought iron
 6 Asbestos-Cement
 7 Fiberglass

- 8 Concrete tile
 9 Other (specify below)


TYPE OF SCREEN OR PERFORATION MATERIAL:

- 1 Steel
 2 Brass
 3 Stainless steel
 4 Galvanized steel

- 5 Fiberglass
 6 Concrete tile

7 PVC

8 RMP (SR)

9 ABS

10 Asbestos-cement

11 Other (specify)

12 None used (open hole)

SCREEN OR PERFORATION OPENINGS ARE:

- 1 Continuous slot
 2 Louvered shutter
3 Mill slot
 4 Key punched

5 Gauzed wrapped

6 Wire wrapped

7 Torch cut

8 Saw cut

9 Drilled holes

10 Other (specify)

11 None (open hole)


6 GROUT MATERIAL:

1 Neat cement

2 Cement grout

3 Bentonite

4 Other Grout intervals: From 9 ft. to 54 ft., From 54 ft. to 93 ft., From 54 ft. to 93 ft.

What is the nearest source of possible contamination:

- 1 Septic tank
 2 Sewer lines
 3 Watertight sewer lines
 4 Lateral lines
 5 Cess pool
 6 Seepage pit

- 7 Pit privy
 8 Sewage lagoon
 9 Feedyard

10 Livestock pens

11 Fuel storage

12 Fertilizer storage

13 Insecticide storage

14 Abandoned water well

15 Oil well/Gas well

16 Other (specify below)

Direction from well?

WestHow many feet? 50

FROM	TO	LITHOLOGIC LOG	FROM	TO	LITHOLOGIC LOG
0	2	Top soil			
2	8	clay			
8	31	sand			
31	32	clay			
32	47	sand			
47	69	Clay			
69	93	med sand			
93	93	clay			

7 CONTRACTOR'S OR LANDOWNER'S CERTIFICATION: This water well was (1) constructed, (2) reconstructed, or (3) plugged under my jurisdiction and was

completed on (mo/day/year) 11-16-86 and this record is true to the best of my knowledge and belief. KansasWater Well Contractor's License No. 318 This Water Well Record was completed on (mo/day/yr) 11-17-86under the business name of Wenger Dullery by (signature) [Signature]

INSTRUCTIONS: Use typewriter or ball point pen. PLEASE PRESS FIRMLY and PRINT clearly. Please fill in blanks, underline or circle the correct answers. Send top three copies to Kansas Department of Health and Environment, Office of Oil Field and Environmental Geology, Regulation and Permitting Section, Topeka, Kansas 66620-7500, Telephone: 913-862-9360. Send one to WATER WELL OWNER and retain one for your records.

OFFICE USE ONLY

T

R

EW

SEC.

1/4

1/4

1/4