WATER WELL RECORD Form WWC-5 KSA 82a-1212

1 LOCATION OF WATER WELL:	Fraction	Section Number	Township Number	Range Number
County: SEDGWICK	SE ¼ NE ¼ SE ¼	23	T 26 S	R 1 E(W)

Distance and direction from nearest town or city street address of well if located within city?
N. ¼ mi & E. ¾ mi. from 45th Street N. & Hoover, Wichita

2 WATER WELL OWNER: City of Wichita
RR#, St. Address, Box # : 455 N. Main
City, State, ZIP Code : Wichita, KS 67202

Board of Agriculture, Division of Water Resources
Application Number:

3 LOCATE WELL'S LOCATION WITH AN "X" IN SECTION BOX:

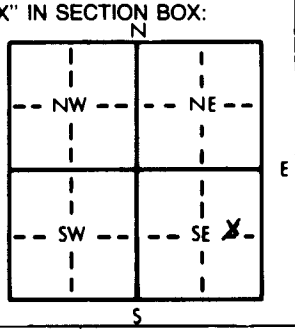

4 DEPTH OF COMPLETED WELL 24.70 ft. ELEVATION:
Depth(s) Groundwater Encountered 1. ft. 2. ft. 3. ft.
WELL'S STATIC WATER LEVEL ft. below land surface measured on mo/day/yr
Pump test data: Well water was ft. after hours pumping gpm
Est. Yield gpm: Well water was ft. after hours pumping gpm
Bore Hole Diameter 9 5/8 in. to 27 ft., and in. to ft.
WELL WATER TO BE USED AS: 5 Public water supply 8 Air conditioning 11 Injection well
1 Domestic 3 Feedlot 6 Oil field water supply 9 Dewatering 12 Other (Specify below)
2 Irrigation 4 Industrial 7 Lawn and garden only (10) Observation well ground-water monitoring
Was a chemical/bacteriological sample submitted to Department? Yes (No); If yes, mo/day/yr sample was submitted
Water Well Disinfected? Yes (No)

5 TYPE OF BLANK CASING USED: 5 Wrought iron 8 Concrete tile CASING JOINTS: Glued Clamped
1 Steel 3 RMP (SR) 6 Asbestos-Cement 9 Other (specify below) Welded
(2 PVC) 4 ABS 7 Fiberglass (Threaded)
Blank casing diameter 2 in. to 14.70 ft., Dia in. to ft., Dia in. to ft.
Casing height above land surface 2.57 ft. in., weight lbs./ft. Wall thickness or gauge No. 40
TYPE OF SCREEN OR PERFORATION MATERIAL: (7 PVC) 10 Asbestos-cement
1 Steel 3 Stainless steel 5 Fiberglass 8 RMP (SR) 11 Other (specify)
2 Brass 4 Galvanized steel 6 Concrete tile 9 ABS 12 None used (open hole)
SCREEN OR PERFORATION OPENINGS ARE: 5 Gauzed wrapped 8 Saw cut 11 None (open hole)
1 Continuous slot (3 Mill slot) 6 Wire wrapped 9 Drilled holes
2 Louvered shutter 4 Key punched 7 Torch cut 10 Other (specify)
SCREEN-PERFORATED INTERVALS: From 14.70 ft. to 24.70 ft., From ft. to ft.
From [redacted] ft. to [redacted] ft., From ft. to ft.
GRAVEL PACK INTERVALS: From 12.60 ft. to 24.70 ft., From ft. to ft.
From ft. to ft., From ft. to ft.

6 GROUT MATERIAL: (1 Neat cement) 2 Cement grout (3 Bentonite) 4 Other
Grout Intervals: From 2 ft. to 12.6 ft., From 0 ft. to 2 ft., From ft. to ft.
What is the nearest source of possible contamination: 10 Livestock pens 14 Abandoned water well
1 Septic tank 4 Lateral lines 7 Pit privy 11 Fuel storage 15 Oil well/Gas well
2 Sewer lines 5 Cess pool 8 Sewage lagoon 12 Fertilizer storage 16 Other (specify below)
3 Watertight sewer lines 6 Seepage pit 9 Feedyard 13 Insecticide storage
Direction from well? How many feet?

FROM	TO	LITHOLOGIC LOG	FROM	TO	LITHOLOGIC LOG
0	5'	Soil			
5	25'	Sand			

7 CONTRACTOR'S OR LANDOWNER'S CERTIFICATION: This water well was (1) constructed, (2) reconstructed, or (3) plugged under my jurisdiction and was completed on (mo/day/year) 12-10-89 and this record is true to the best of my knowledge and belief. Kansas Water Well Contractor's License No. 468 This Water Well Record was completed on (mo/day/yr) 12-5-88 under the business name of J & R Drilling Services, INC by (signature) Raymond Coons

INSTRUCTIONS: Use typewriter or ball point pen. *PLEASE PRESS FIRMLY* and *PRINT* clearly. Please fill in blanks, underline or circle the correct answers. Send top three copies to Kansas Department of Health and Environment, Bureau of Water Protection, Topeka, Kansas 66620-7320, Telephone: 913-862-9360. Send one to WATER WELL OWNER and retain one for your records.

OFFICE USE ONLY T R E/W SEC. ¼ ¼ ¼