USE TYPEWRITER OR BALL POINT PEN-PRESS FIRMLY, PRINT CLEARLY.

WATER WELL RECORD
KSA 82a-1201-1215

Kansas Department of Health and Environment-Division of Environment
(Water well Contractors)
Topeka, Kansas 66620

1. Location of well:	County: Sedgwick	Fraction: SE 1/4 NE 1/4 SE 1/4	Section number: 29	Township number: T 26 S	Range number: R 1 (W)

2. Distance and direction from nearest town or city: 1 E 2 So Maize Ks
Street address of well location if in city: 37th No & Tyler Rd.

3. Owner of well: Jim Loehr
R.R. or street: 13½ So Westfield
City, state, zip code: Wichita Ks 67209

4. Locate with "X" in section below:

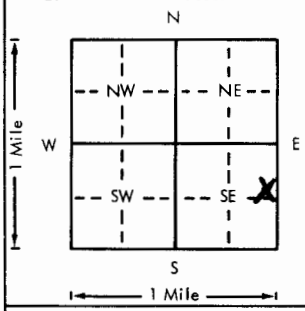

Sketch map:

6. Bore hole dia. 11 in. Completion date 10/20/78
Well depth 50 ft.

7. __ Cable tool X Rotary __ Driven __ Dug
__ Hollow rod __ Jetted __ Bored __ Reverse rotary

8. Use: X Domestic __ Public supply __ Industry
__ Irrigation __ Air conditioning __ Stock
__ Lawn __ Oil field water __ Other

9. Casing: Material Styrene Weight (Above) or below
Threaded ___ Welded X Surface 12 in.
RMP X PVC ___ Weight 1.50 lbs./ft.
Dia. 5 in. to 50 ft. depth Wall Thickness: inches or
Dia. ___ in. to ___ ft. depth gage No. 200

10. Screw: Manufacturer's name Sunflower
Type 200 Dia. 5 in
(Slot) gauze 1/16 Length 10
Set between 40 ft. and 50 ft.
___ ft. and ___ ft.
Gravel pack? Yes Size range of material 3/8

11. Static water level: mo./day/yr.
16 ft. below land surface Date 10/20/78

12. Pumping level below land surfaces:
18 ft. after ½ hrs. pumping 15 g.p.m.
___ ft. after ___ hrs. pumping ___ g.p.m.
Estimated maximum yield 50-60 g.p.m.

13. Water sample submitted: mo./day/yr.
__ Yes X No Date ___

14. Well head completion:
__ Pitless adapter 12 Inches above grade

15. Well grouted? Yes
With: __ Neat cement __ Bentonite X Concrete
Depth: From 0 ft. to 10 ft.

16. Nearest source of possible contamination:
ft. 80 Direction W. Type Septic
Well disinfected upon completion? X Yes __ No

17. Pump: X Not installed
Manufacturer's name ___
Model number ___ HP ___ Volts ___
Length of drop pipe ___ ft. capacity ___ g.p.m.
Type:
__ Submersible __ Turbine
__ Jet __ Reciprocating
__ Centrifugal __ Other

5. Type and color of material	From	To
Top soil	0	2
red clay	2	8
fine sand	8	20
med gravel.	20	35
red clay	35	36
course gravel	36	50

(Use a second sheet if needed)

18. Elevation:
Topography:
X Hill
__ Slope
__ Upland
__ Valley

19. Remarks:

20. Water well contractor's certification:
This well was drilled under my jurisdiction and this report is true to the best of my knowledge and belief.
Business name Layne & Bowler 318 License No.
Address Colwich Ks
Signed [signature] Authorized representative 10/20/78

T 26 R 1 (W) Sec 29 1/4 SE 1/4 NE 1/4 SE 1/4

Forward the white, blue and pink copies to the Department of Health and Environment

Form WWC-5

MI-1023