USE TYPEWRITER OR BALL POINT PEN-PRESS FIRMLY, PRINT CLEARLY.

WATER WELL RECORD
KSA 82a-1201-1215

Kansas Department of Health and Environment-Division of Environment
(Water well Contractors)
Topeka, Kansas 66620

1. Location of well: County: Sedgwick | Fraction: NW 1/4 NW 1/4 NE 1/4 | Section number: 30 | Township number: T 26 S | Range number: R 1 E/W

2. Distance and direction from nearest town or city:
Street address of well location if in city: 10917 W. 45th North

3. Owner of well: Carl Dorham
R.R. or street: 10917 W. 45th No.
City, state, zip code: Maize, Ks.

4. Locate with "X" in section below:

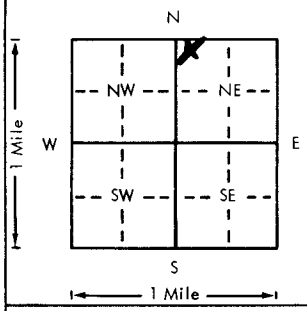

Sketch map:

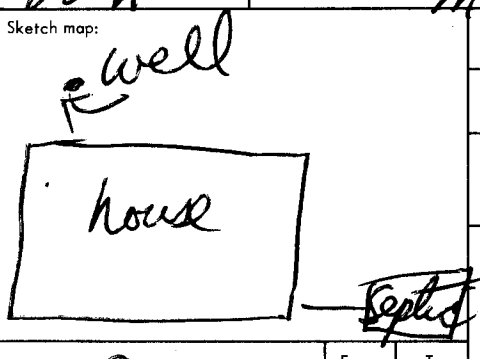

6. Bore hole dia. 4 in. Completion date 11/3/78
Well depth 50 ft.

7. __ Cable tool X Rotary __ Driven __ Dug
__ Hollow rod __ Jetted __ Bored __ Reverse rotary

8. Use: X Domestic __ Public supply __ Industry
__ Irrigation __ Air conditioning __ Stock
__ Lawn __ Oil field water __ Other

9. Casing: Material: Surplus Height: Above or below
Threaded ___ Welded X Surface 12 in.
RMP X PVC ___ Weight 1.50 lbs./ft.
Dia. 5 in. to 50 ft. depth Wall Thickness: inches or
Dia. ___ in. to ___ ft. depth gage No. 200

10. Screen: Manufacturer's name Sunflower
Type 200 Dia. 5 in
Slot/gauze 110 Length 7 ft
Set between 43 ft. and 50 ft.
___ ft. and ___ ft.
Gravel pack? yes Size range of material 3/8

11. Static water level:
21 ft. below land surface Date mo./day/yr. 11/3/78

12. Pumping level below land surfaces:
22 ft. after 1/2 hrs. pumping 15 g.p.m.
___ ft. after ___ hrs. pumping ___ g.p.m.
Estimated maximum yield 50 g.p.m.

13. Water sample submitted: mo./day/yr.
__ Yes X No Date

14. Well head completion:
X Pitless adapter 12 inches above grade

15. Well grouted? yes
With: __ Neat cement __ Bentonite X Concrete
Depth: From 3 ft. to 13 ft.

16. Nearest source of possible contamination:
ft. 150 Direction SE Type Septic
Well disinfected upon completion? X Yes __ No

17. Pump: Not installed
Manufacturer's name Valley
Model number 1805 HP 1/2 Volts 220
Length of drop pipe 40 ft. capacity 15 g.p.m.
Type:
X Submersible __ Turbine
__ Jet __ Reciprocating
__ Centrifugal __ Other

5. Type and color of material

	From	To
Top soil.	0	2
red clay.	2	22
med. gravel	22	33
red clay.	33	34
course gravel.	34	50

(Use a second sheet if needed)

18. Elevation:
Topography:
X Hill
__ Slope
__ Upland
__ Valley

19. Remarks: Customer to furnish 4'x4'x4" slab around well at grade
Re: State Regulations
Signed X Carl A Dorham

20. Water well contractor's certification:
This well was drilled under my jurisdiction and this report is true to the best of my knowledge and belief.
Business name Wayne's Well Service License No. 318
Address Colwich
Signed [signature] Authorized representative Date 11/3/78

26 T — 1 R — 30 Sec — NW 1/4 NW 1/4 NE 1/4

Forward the white, blue and pink copies to the Department of Health and Environment

Form WWC-5

MI-1023