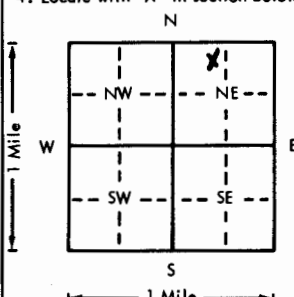
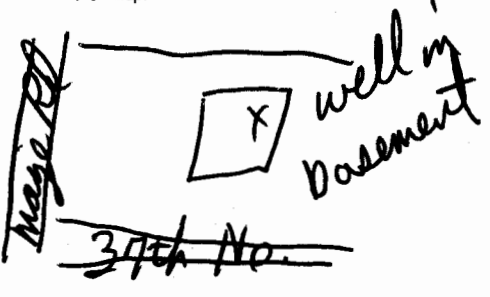


USE TYPEWRITER OR BALL
POINT PEN-PRESS FIRMLY,
PRINT CLEARLY.

WATER WELL RECORD
KSA 82a-1201-1215

Kansas Department of Health and
Environment-Division of Environment
(Water well Contractors)
Topeka, Kansas 66620

1. Location of well:		County <u>Sedg.</u>	Fraction <u>NE 1/4 NW 1/4 NE 1/4</u>	Section number <u>31</u>	Township number <u>T 26 S</u>	Range number <u>R 1 E W</u>
2. Distance and direction from nearest town or city: Street address of well location if in city:		<u>2.50 1/4 W. MAIZE KS.</u>		3. Owner of well: <u>Woody Mauldin</u> R.R. or street: <u>5320 Porter</u> City, state, zip code: <u>Wichita KS 67212</u>		
4. Locate with "X" in section below:		Sketch map:		6. Bore hole dia. <u>5</u> in. Completion date <u>6/7/77</u> Well depth <u>65</u> ft.		
				7. ☒ Cable tool ☒ Rotary ☐ Driven ☐ Dug ☐ Hollow rod ☐ Jetted ☐ Bored ☐ Reverse rotary		
5. Type and color of material		From		To		8. Use: ☒ Domestic ☐ Public supply ☐ Industry ☐ Irrigation ☐ Air conditioning ☐ Stock ☐ Lawn ☐ Oil field water ☐ Other
<u>Top soil</u>		<u>0</u>		<u>6</u>		9. Casing: Material <u>PVC</u> Height: <u>Above</u> or below Threaded ☐ Welded ☒ Surface <u>12</u> in. RMP ☐ PVC ☒ Weight <u>231</u> lbs./ft. Dia. <u>5</u> in. to <u>65</u> ft. depth Wall Thickness: inches or Dia. <u>5</u> in. to <u>65</u> ft. depth gage No. <u>160</u>
<u>clay red</u>		<u>6</u>		<u>18</u>		10. Screen: Manufacturer's name <u>Pumpeo</u> Type <u>PVC</u> Dia. <u>5</u> in. Net/gauze <u>1/16</u> Length <u>5</u> ft. Set between <u>60</u> ft. and <u>65</u> ft. ft. and ft. Gravel pack? ☒ Size range of material <u>3/8</u>
<u>fine sand</u>		<u>18</u>		<u>33</u>		11. Static water level: <u>22</u> ft. below land surface Date <u>6/7/77</u>
<u>clay</u>		<u>33</u>		<u>34</u>		12. Pumping level below land surfaces: <u>22</u> ft. after <u>12</u> hrs. pumping <u>20</u> g.p.m. ft. after hrs. pumping g.p.m. Estimated maximum yield <u>50</u> g.p.m.
<u>med to coarse gravel</u>		<u>34</u>		<u>65</u>		13. Water sample submitted: <u>Yes</u> ☒ No Date
						14. Well head completion: Pitless adapter <u>12</u> inches above grade
						15. Well grouted? <u>Yes</u> With: <u>Neat cement</u> ☒ Bentonite ☐ Concrete ☐ Depth: From <u>8</u> ft. to <u>18</u> ft.
						16. Nearest source of possible contamination: ft. Direction <u>NONE</u> Well disinfected upon completion? ☒ Yes ☐ No
						17. Pump: ☒ Not installed Manufacturer's name Model number HP Volts Length of drop pipe ft. capacity g.p.m. Type: ☐ Submersible ☐ Turbine ☐ Jet ☐ Reciprocating ☐ Centrifugal ☐ Other
						20. Water well contractor's certification: This well was drilled under my jurisdiction and this report is true to the best of my knowledge and belief. <u>Henry H. Helling</u> 318 Business name <u>Colwich KS</u> License No. Address <u>Wichita KS</u> Signed <u>Henry H. Helling</u> Date <u>6/7/77</u> Authorized representative
18. Elevation:		19. Remarks:				
Topography: ☐ Hill ☒ Slope ☒ Upland ☐ Valley						

Forward the white, blue and pink copies to the Department of Health and Environment

Form WWC-5