USE TYPEWRITER OR BALL POINT PEN-PRESS FIRMLY, PRINT CLEARLY.

WATER WELL RECORD
KSA 82a-1201-1215

Kansas Department of Health and Environment-Division of Environment
(Water well Contractors)
Topeka, Kansas 66620

1. Location of well:	County	Fraction	Section number	Township number	Range number
	Sedgwick	SE 1/4 NE 1/4 SE 1/4	31	T 26 S	R 1W E/W

2. Distance and direction from nearest town or city:
Street address of well location if in city: 31st & MaizeRoad ¼ West on the north

3. Owner of well: Jerry Falke
R.R. or street: 120 East Ross
City, state, zip code: Clearwater, Kansas

4. Locate with "X" in section below:

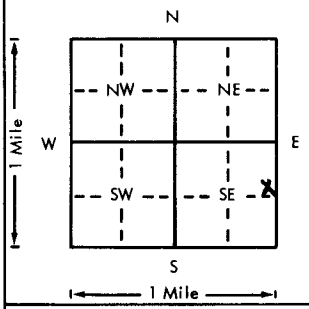

Sketch map:
side.
Wichita, Kansas

6. Bore hole dia. 11 in. Completion date
Well depth 60 ft. 5-14-77

7. __ Cable tool X Rotary __ Driven __ Dug
__ Hollow rod __ Jetted __ Bored __ Reverse rotary

8. Use: X Domestic __ Public supply __ Industry
__ Irrigation __ Air conditioning __ Stock
__ Lawn __ Oil field water __ Other

9. Casing: Material styrene Height: Above or below
Threaded __ Welded gl Surface 12 in.
RMP X PVC Weight lbs./ft.
Dia. 5 60 to ft. depth Wall Thickness: inches or
Dia. in. to ft. depth gage No. 200

5. Type and color of material	From	To
Topsoil	0	3
Clay	3	25
Fine Sand	2 5	40
Medium Sand	40	60
(Use a second sheet if needed)		

10. Screen: Manufacturer's name Sunflower Plastic
Type styrene Dia. 5"
Slot/gauze .06 Length 15'
Set between 45 ft. and 60 ft.
ft. and ft.
Gravel pack? yes Size range of material ¼ 1/8"

11. Static water level: mo./day/yr.
20 ft. below land surface Date 5-14-77

12. Pumping level below land surfaces:
ft. after hrs. pumping g.p.m.
ft. after hrs. pumping g.p.m.
Estimated maximum yield g.p.m.

13. Water sample submitted: mo./day/yr.
__ Yes __ No Date

14. Well head completion: well seal
__ Pitless adapter 12 Inches above grade

15. Well grouted? ~~yes~~ 1-2 fine sand mix
With: __ Neat cement __ Bentonite X Concrete
Depth: From 40" ft. to 14 ft.

16. Nearest source of possible contamination: NONE
ft. Direction Type
Well disinfected upon completion? X Yes __ No

17. Pump: Not installed
Manufacturer's name Sta-Rite
Model number 20p4D02 HP 3/4 Volts 230
Length of drop pipe 40 ft. capacity 20 g.p.m.
Type:
X Submersible __ Turbine
__ Jet __ Reciprocating
__ Centrifugal __ Other

T 26 R 1 E/W Sec 31 1/4 NESE 1/4 1/4

18. Elevation:
Topography:
__ Hill
__ Slope
__ Upland
__ Valley

19. Remarks:
Septic system not installed when well was drilled.
No apparent source for contamination
Flat Ground

20. Water well contractor's certification:
This well was drilled under my jurisdiction and this report is true to the best of my knowledge and belief.
Harp Well & Pump 236
Business name Wichita, Kansas License No.
Address
Signed M. Arnold Date 10-7-77
Authorized representative

Forward the white, blue and pink copies to the Department of Health and Environment

Form WWC-5

MI-1023