


1 LOCATION OF WATER WELL: Sedgwick	FRACTION SE 1/4 SE 1/4 SE 1/4	Section Number 33	Township Number T 26 S	Range Number R 1W E/W
--	---	-----------------------------	----------------------------------	---------------------------------

Distance and direction from nearest town or city street address of well if located within city?
29th and Ridge Road Wichita, Kansas

2 WATER WELL OWNER: City of Wichita RR#, ST. ADDRESS, BOX #: P.O. Box 19163 CITY, STATE, ZIP CODE: Wichita, Kansas 67277	Board of Agriculture, Division of Water Resource Application Number:
--	---

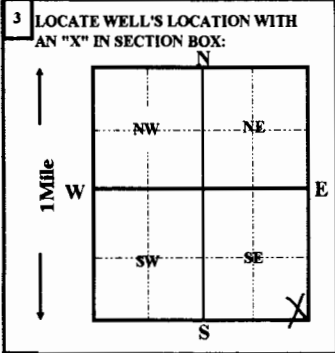

4 DEPTH OF COMPLETED WELL 40 ft. ELEVATION:	Depth(s) groundwater Encountered 1 ft. 2 ft. 3 ft.
WELL'S STATIC WATER LEVEL 10 FT. BELOW LAND SURFACE MEASURED ON mo/day/yr 04/14/1994	
Pump test data: Well water was	ft. after hours pumping gpm
Est. Yield gpm: Well water was	ft. after hours pumping gpm
Bore Hole Diameter 12 in. to 40 ft. and in. to ft.	
WELL WATER TO BE USED AS:	
1 Domestic	5 Public water supply
2 Irrigation	6 Oil field water supply
3 Feedlot	7 Lawn and garden only
4 Industrial	8 Air conditioning
6 Oil field water supply	9 Dewatering
7 Lawn and garden only	10 Monitoring well
8 Air conditioning	11 Injection well
9 Dewatering	12 Other (Specify below)
10 Monitoring well	
Was a chemical/bacteriological sample submitted to Department? Yes No <input checked="" type="checkbox"/> ; If yes, mo/day/yr sample was submitted	
Water Well Disinfected? Yes <input checked="" type="checkbox"/> No	

5 TYPE OF CASING USED:	1 Steel	2 PVC	3 RMP (SR)	4 ABS	5 Wrought iron	6 Asbestos-Cement	7 Fiberglass	8 Concrete tile	9 Other (Specify below)	CASING JOINTS:	Glued <input checked="" type="checkbox"/> Clamped	Welded	Threaded	
Blank casing Diameter 8 in. to 20 ft., Dia in. to ft., Dia in. to ft.	Casing height above land surface 24 in., weight 5.59 lbs./ft.	TYPE OF SCREEN OR PERFORATION MATERIAL:	1 Steel	2 Brass	3 Stainless Steel	4 Galvanized steel	5 Fiberglass	6 Concrete tile	7 PVC	8 RMP (SR)	9 SDR-26	10 Asbestos-cement	11 other (specify)	12 None used (open hole)
SCREEN OR PERFORATION OPENING ARE:	1 Continuous slot	2 Louvered shutter	3 Mill slot	4 Key punched	5 Gauzed wrapped	6 Wire wrapped	7 Torch cut	8 Saw cut	9 Drilled holes	10 Other (specify)	11 None (open hole)			
SCREEN-PERFORATION INTERVALS:	from 20 ft. to 40 ft., From ft. to ft.													
GRAVEL PACK INTERVALS:	from 20 ft. to 40 ft., From ft. to ft.													

6 GROUT MATERIAL:	1 Neat cement	2 Cement grout	3 Bentonite	4 Other bentonite hole plug
Grout Intervals: From 0 ft. to 20 ft. From ft. to ft.	What is the nearest source of possible contamination:			
1 Septic tank	2 Sewer lines	3 Watertight sewer lines	4 Lateral lines	5 Cess pool
6 Seepage pit	7 Pit privy	8 Sewage lagoon	9 Feedyard	10 Livestock pens
	11 Fuel storage	12 Fertilizer storage	13 Insecticide storage	14 Abandon water well
	15 Oil well/Gas well	16 Other (specify below)		None Apparent
Direction from well? How many feet?				

FROM	TO	LITHOLOGIC LOG	FROM	TO	PLUGGING INTERVALS
0	2	topsoil			
2	10	sandy clay			
10	21	medium to coarse sand			
21	24	clay			
24	40	medium to coarse sand			

7 CONTRACTOR'S OR LANDOWNER'S CERTIFICATION: This water well was (1) constructed, (2) reconstructed, or (3) plugged under my jurisdiction and was completed on (mo/day/year) 04/14/1994 and this record is true to the best of my knowledge and belief. Kansas Water Well Contractor's License No. 236 This Water Well Record was completed on (mo/day/yr) 04/22/94 Under the business name of Harp Well & Pump Service, Inc by (signature)	<i>Jane Frederick</i>
---	-----------------------