


1 LOCATION OF WATER WELL: Sedgwick	FRACTION SW 1/4 SW 1/4 SW 1/4	Section Number 15	Township Number T 26 S	Range Number R 1W EW
--	---	-----------------------------	----------------------------------	--------------------------------

Distance and direction from nearest town or city street address of well if located within city?

7158 W. 53rd N. Wichita, Kansas

2 WATER WELL OWNER: HOLMES, George RR#, ST. ADDRESS, BOX #: 7158 W. 53rd N. CITY, STATE, ZIP CODE: Wichita, Kansas	Board of Agriculture, Division of Water Resource Application Number:
---	---

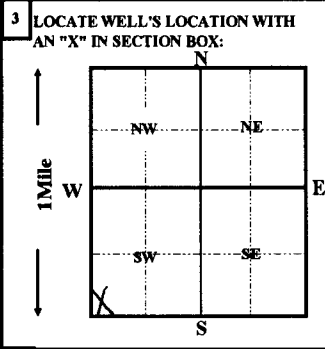

4 DEPTH OF COMPLETED WELL 114 ft. ELEVATION:	Depth(s) groundwater Encountered 1 ft. 2 ft. 3 ft.
WELL'S STATIC WATER LEVEL 15 FT. BELOW LAND SURFACE MEASURED ON mo/day/yr 12/12/1994	
Pump test data: Well water was _____ ft. after _____ hours pumping _____ gpm	
Est. Yield gpm: Well water was _____ ft. after _____ hours pumping _____ gpm	
Bore Hole Diameter 12 in. to 114 ft. and _____ in. to _____ ft.	
WELL WATER TO BE USED AS: 5 Public water supply 8 Air conditioning 11 Injection well	
1 Domestic 3 Feedlot 6 Oil field water supply 9 Dewatering 12 Other (Specify below)	
2 Irrigation 4 Industrial 7 Lawn and garden only 10 Monitoring well	
Was a chemical/bacteriological sample submitted to Department? Yes _____ No <input checked="" type="checkbox"/> ; If yes, mo/day/yr sample was submitted _____	
Water Well Disinfected? Yes <input checked="" type="checkbox"/> No _____	

5 TYPE OF CASING USED:	5 Wrought iron	8 Concrete tile	CASING JOINTS: Glued <input checked="" type="checkbox"/> Clamped
1 Steel	3 RMP (SR)	6 Asbestos-Cement	9 Other (Specify below)
2 PVC	4 ABS	7 Fiberglass	SDR-26
Blank casing Diameter 5 in. to 94 ft., Dia _____ in. to _____ ft.		Wall thickness or gauge No. .214	
Casing height above land surface 12 in., weight 2.35 lbs./ft.		10 Asbestos-cement	
TYPE OF SCREEN OR PERFORATION MATERIAL:			
1 Steel	3 Stainless Steel	5 Fiberglass	8 RMP (SR)
2 Brass	4 Galvanized steel	6 Concrete tile	9 ABS
SCREEN OR PERFORATION OPENING ARE:		8 Saw cut	11 None (open hole)
1 Continuous slot	3 Mill slot	9 Drilled holes	
2 Louvered shutter	4 Key punched	10 Other (specify)	
SCREEN-PERFORATION INTERVALS: from 94 ft. to 114 ft., From _____ ft. to _____ ft.			
GRAVEL PACK INTERVALS: from 24 ft. to 114 ft., From _____ ft. to _____ ft.			

6 GROUT MATERIAL: 1 Neat cement	2 Cement grout	3 Bentonite	4 Other bentonite hole plug
Grout intervals: From 4 ft. to 24 ft.	From 91 ft. to 94 ft.	ft. From _____ ft. to _____ ft.	ft. From _____ ft. to _____ ft.
What is the nearest source of possible contamination:			
1 Septic tank	4 Lateral lines	7 Pit privy	10 Livestock pens
2 Sewer lines	5 Cess pool	8 Sewage lagoon	11 Fuel storage
3 Watertight sewer lines	6 Seepage pit	9 Feedyard	12 Fertilizer storage
			13 Insecticide storage
Direction from well? West		How many feet? 150	

FROM	TO	LITHOLOGIC LOG	FROM	TO	PLUGGING INTERVALS
0	3	topsoil			
3	10	clay			
10	21	fine sand			
21	47	medium sand & small gravel			
47	50	clay			
50	81	fine sand			
81	84	clay			
84	91	fine sand			
91	93	clay			
93	112	fine sand			
112	114	grey shale			

7 CONTRACTOR'S OR LANDOWNER'S CERTIFICATION: This water well was (1) constructed, (2) reconstructed, or (3) plugged under my jurisdiction and was completed on (mo/day/year) **12/12/1994** and this record is true to the best of my knowledge and belief. Kansas Water Well Contractor's License No. **236**. This Water Well Record was completed on (mo/day/yr) **12/20/94**. Under the business name of **Harp Well & Pump Service, Inc.** by (signature) *Jane Frederick*