

Site 35, well #1

WATER WELL RECORD Form WWC-5 KSA 82a-1212

LOCATION OF WATER WELL	Fraction	Section Number	Township Number	Range Number
County: <u>Reno</u>	<u>SW 1/4</u> <u>SW 1/4</u> <u>SW 1/4</u>	<u>31</u>	<u>T 26 S</u>	<u>R 10 E</u> (W)

Distance and direction from nearest town or city?

5 mi. S, 2 mi. W. of Turon

Street address of well if located within city?

WATER WELL OWNER: KGS

RR#, St. Address, Box #

City, State, ZIP Code

Board of Agriculture, Division of Water Resources
Application Number:DEPTH OF COMPLETED WELL: 173 ft. Bore Hole Diameter: 9 7/8 in. to ft., and in. to

Well Water to be used as:

1 Domestic	3 Feedlot	5 Public water supply	8 Air conditioning	11 Injection well
2 Irrigation	4 Industrial	6 Oil field water supply	9 Dewatering	(12) Other (Specify below)
		7 Lawn and garden only	10 Observation well	<u>Research</u>

Well's static water level: 24.5 ft. below land surface measured on Jan month 28 day 1983 year

Pump Test Data

Well water was	ft. after	hours pumping	gpm
Est. Yield	gpm	Well water was	ft. after
		hours pumping	gpm

TYPE OF BLANK CASING USED:

1 Steel	3 RMP (SR)	5 Wrought iron	8 Concrete tile	Casing Joints: Glued <u>X</u> Clamped
(2) PVC	4 ABS	6 Asbestos-Cement	9 Other (specify below)	Welded
		7 Fiberglass		Threaded

Blank casing dia: 5 in. to ft., Dia in. to ft., Dia in. to ft.

Casing height above land surface: 12 in., weight lbs./ft. Wall thickness or gauge No. Schedule 1120

TYPE OF SCREEN OR PERFORATION MATERIAL:

1 Steel	3 Stainless steel	5 Fiberglass	8 RMP (SR)	10 Asbestos-cement
2 Brass	4 Galvanized steel	6 Concrete tile	9 ABS	11 Other (specify)
				12 None used (open hole)

Screen or Perforation Openings Are:

1 Continuous slot	(3) Mill slot	5 Gauzed wrapped	8 Saw cut	11 None (open hole)
2 Louvered shutter	4 Key punched	6 Wire wrapped	9 Drilled holes	
		7 Torch cut	10 Other (specify)	

Screen-Perforation Dia: 5 in. to ft., Dia in. to ft., Dia in. to ft.Screen-Perforated Intervals: From 173 ft. to 168 ft., From ft. to ft., From ft. to ft., From ft. to ft.Gravel Pack Intervals: From 173 ft. to 163 ft., From ft. to ft., From ft. to ft., From ft. to ft.

GROUT MATERIAL: (1) Neat cement 2 Cement grout 3 Bentonite 4 Other

Grouted Intervals: From 163 ft. to 133 ft., From ft. to ft., From ft. to ft., From ft. to ft.

What is the nearest source of possible contamination:

1 Septic tank	4 Cess pool	7 Sewage lagoon	10 Fuel storage	14 Abandoned water well
2 Sewer lines	5 Seepage pit	8 Feed yard	11 Fertilizer storage	15 Oil well/Gas well
3 Lateral lines	6 Pit privy	9 Livestock pens	12 Insecticide storage	16 Other (specify below)
			13 Watertight sewer lines	

Direction from well: How many feet: ? Water Well Disinfected? Yes No

Was a chemical/bacteriological sample submitted to Department? Yes No

If yes, date sample was submitted: month day year: Pump Installed? Yes No

If Yes: Pump Manufacturer's name: Model No. HP Volts

Depth of Pump Intake ft. Pumps Capacity rated at gal./min


Type of pump: 1 Submersible 2 Turbine 3 Jet 4 Centrifugal 5 Reciprocating 6 Other

CONTRACTOR'S OR LANDOWNER'S CERTIFICATION: This water well was (1) constructed, (2) reconstructed, or (3) plugged under my jurisdiction and was completed on June month 10 day 1982 year

and this record is true to the best of my knowledge and belief. Kansas Water Well Contractor's License No.

This Water Well Record was completed on month day year under the business name of by (signature)

LOCATE WELL'S LOCATION WITH AN "X" IN SECTION BOX:

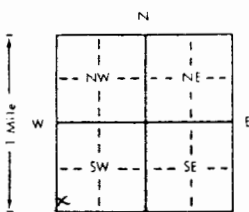

FROM	TO	LITHOLOGIC LOG	FROM	TO	LITHOLOGIC LOG
0	14	reddish-brown silty sandy clay	99	120	sand interbedded with
14	28	fine to med. grained sand	1		sandy clay
28	32	reddish brown sandy clay	120	125	clay interbedded with sand
32	35	sand and gravel interbedded with thin clay layers	125	127	sand and gravel
35	37	reddish-brown silty clay	127	148	gray-brown silty clay
37	71	sand and gravel	148	155	sand and gravel
71	90	gray-brown sandy clay interbedded with sand	155	173	red shale
90	94	sand and gravel			(abbreviated log)
94	99	brown clay, slightly sandy			


ELEVATION: 1759.7

Depth(s) Groundwater Encountered 1. ft. 2. ft. 3. ft. 4. ft. (Use a second sheet if needed)

INSTRUCTIONS: Use typewriter or ball point pen, please press firmly and PRINT clearly. Please fill in blanks, underline or circle the correct answers. Send top three copies to Kansas Department of Health and Environment, Division of Environment, Water Well Contractors, Topeka, KS 66620. Send one to WATER WELL OWNER and retain one for your records.

SITE NUMBER : 35 (KP1Q)
SITE LOCATION : SW SW SW
LEGAL LOCATION: 31-26-10W
COUNTY : RENO

LANDOWNER: MRS. CHARLES HANSEN
ADDRESS : C/O BILL SCHAEFER
8633 W. 90TH TERRACE
PHONE NO.: OVERLAND-PARK, KS 66212
(913)-649-8633

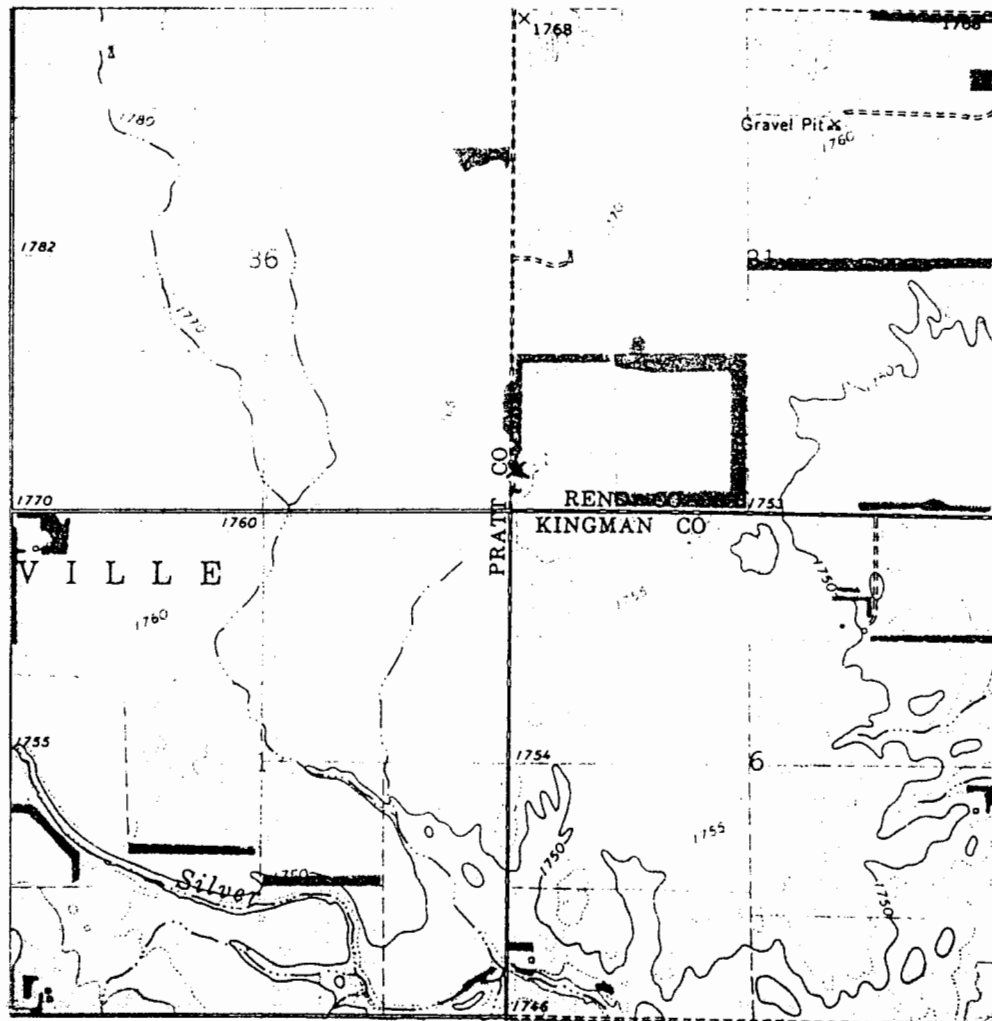

WELL LOCATION X

BIG BEND GMD#5-KGS
WATER QUALITY
OBSERVATION WELL
NETWORK

SITE NUMBER : 35 (KP10)
SITE LOCATION: SW SW SW

LEGAL LOCATION: 31-26-10W
COUNTY : RENO

WELL LOG

[illegible]