

LOCATION OF WATER WELL	Fraction	Section Number	Township Number	Range Number
County: <u>Reed</u>	<u>SW 1/4</u> <u>SW 1/4</u> <u>SW 1/4</u>	<u>31</u>	<u>T 26 S</u>	<u>R 10 E</u> <u>W</u>

Distance and direction from nearest town or city?

5 miles S, 2 mi. W. of Turon

Street address of well if located within city?

WATER WELL OWNER: KGS

R#, St. Address, Box #

Board of Agriculture, Division of Water Resources

City, State, ZIP Code

Application Number:

DEPTH OF COMPLETED WELL: 71 ft. Bore Hole Diameter: 1 in. to 1 ft., and 1 in. to 1 ft.

Well Water to be used as:

1 Domestic 3 Feedlot

2 Irrigation 4 Industrial

5 Public water supply

6 Oil field water supply

7 Lawn and garden only

8 Air conditioning

9 Dewatering

10 Observation well

11 Injection well

12 Other (Specify below)

ResearchWell's static water level: 18.7 ft. below land surface measured on Jan month 28 day 1983 year

Pump Test Data

Well water was 1 ft. after 1 hours pumping 1 gpm

Est. Yield gpm:

Well water was 1 ft. after 1 hours pumping 1 gpm

TYPE OF BLANK CASING USED:

5 Wrought iron

8 Concrete tile

Casing Joints: Glued X Clamped

1 Steel

3 RMP (SR)

6 Asbestos-Cement

9 Other (specify below)

Welded

PVC

4 ABS

7 Fiberglass

Threaded

Blank casing dia: 5 in. to 5 ft., Dia: 1 in. to 1 ft., Dia: 1 in. to 1 ft.Casing height above land surface: 12 in., weight 12 lbs./ft. Wall thickness or gauge No. schedule 1120

TYPE OF SCREEN OR PERFORATION MATERIAL:

1 Steel

3 Stainless steel

5 Fiberglass

8 RMP (SR)

10 Asbestos-cement

2 Brass

4 Galvanized steel

6 Concrete tile

9 ABS

11 Other (specify)

12 None used (open hole)

Screen or Perforation Openings Are:

1 Continuous slot

3 Mill slot

5 Gauzed wrapped

8 Saw cut

11 None (open hole)

2 Louvered shutter

4 Key punched

6 Wire wrapped

9 Drilled holes

Screen-Perforation Dia: 5 in. to 5 ft., Dia: 1 in. to 1 ft., Dia: 1 in. to 1 ft.Screen-Perforated Intervals: From 71 ft. to 66 ft., From 71 ft. to 66 ft., From 71 ft. to 66 ft.Gravel Pack Intervals: From 71 ft. to 60 ft., From 71 ft. to 60 ft., From 71 ft. to 60 ft.GROUT MATERIAL: 1 Neat cement 2 Cement grout 3 Bentonite 4 OtherGrouted Intervals: From 60 ft. to 50 ft., From 60 ft. to 50 ft., From 60 ft. to 50 ft.

What is the nearest source of possible contamination:

1 Septic tank

4 Cess pool

7 Sewage lagoon

10 Fuel storage

14 Abandoned water well

2 Sewer lines

5 Seepage pit

8 Feed yard

11 Fertilizer storage

15 Oil well/Gas well

3 Lateral lines

6 Pit privy

9 Livestock pens

12 Insecticide storage

16 Other (specify below)


Direction from well: 1 How many feet 1 Water Well Disinfected? Yes 1 No 1Was a chemical/bacteriological sample submitted to Department? Yes 1 No 1 If yes, date samplewas submitted 1 month 1 day 1 year: Pump Installed? Yes 1 No 1If Yes: Pump Manufacturer's name 1 Model No. 1 HP 1 Volts 1Depth of Pump Intake 1 ft. Pumps Capacity rated at 1 gal./min

Type of pump: 1 Submersible 2 Turbine 3 Jet 4 Centrifugal 5 Reciprocating 6 Other

CONTRACTOR'S OR LANDOWNER'S CERTIFICATION: This water well was (1) constructed, (2) reconstructed, or (3) plugged under my jurisdiction and was

completed on June month 11 day 1982 yearand this record is true to the best of my knowledge and belief. Kansas Water Well Contractor's License No. 1This Water Well Record was completed on 1 month 1 day 1 year under the businessname of 1 by (signature)

LOCATE WELL'S LOCATION WITH AN "X" IN SECTION BOX:

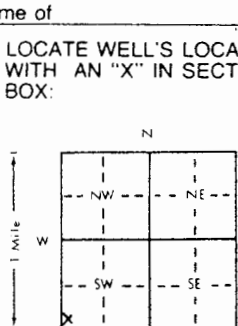

FROM TO LITHOLOGIC LOG FROM TO LITHOLOGIC LOG

0 14 reddish-brown silty sandy clay 1 1 114 28 fine to med. grained sand 1 1 128 32 reddish-brown sandy clay 1 1 132 35 sand and gravel interbedded 1 1 135 37 with thin clay layers 1 1 137 71 reddish-brown silty clay 1 1 171 71 sand and gravel 1 1 11 1 (abbreviated log) 1 1 1ELEVATION: 1759.4Depth(s) Groundwater Encountered 1. 1 ft. 2. 1 ft. 3. 1 ft. 4. 1 ft. (Use a second sheet if needed)


INSTRUCTIONS: Use typewriter or ball point pen, please press firmly and PRINT clearly. Please fill in blanks, underline or circle the correct answers. Send top three

copies to Kansas Department of Health and Environment, Division of Environment, Water Well Contractors, Topeka, KS 66620. Send one to WATER WELL OWNER and

retain one for your records

SITE NUMBER : 35 (KPIQ)
SITE LOCATION : SW SW SW
LEGAL LOCATION: 31-26-10W
COUNTY : RENO

LANDOWNER: MRS. CHARLES HANSEN
ADDRESS : C/O BILL SCHAEFER
8633 W. 90TH TERRACE
PHONE NO.: OVERLAND-PARK, KS 66212
(913)-649-8633

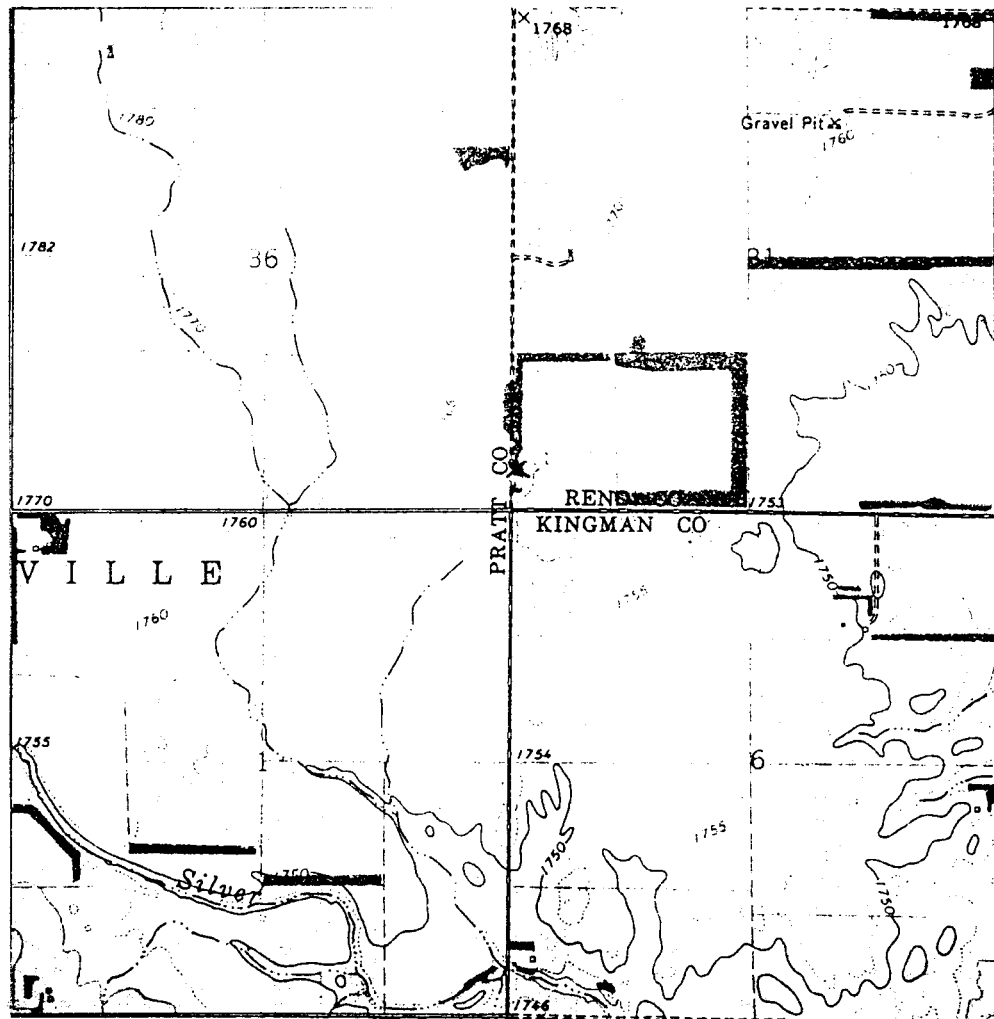

WELL LOCATION X

LEGAL LOCATION: 31-26-10W
COUNTY : RENO

WELL LOG

[illegible]