

Site 35, well #4

WATER WELL RECORD Form WWC-5 KSA 82a-1212

LOCATION OF WATER WELL	Fraction	Section Number	Township Number	Range Number
County: <u>Ren</u>	<u>SW 1/4</u> <u>SW 1/4</u> <u>SW 1/4</u>	<u>31</u>	<u>T 26 S</u>	<u>R 10 EW</u>

Distance and direction from nearest town or city? 5 mi. S, 2 mi. W of Turon

Street address of well if located within city?

WATER WELL OWNER: KGS

RR#, St. Address, Box #

City, State, ZIP Code

Board of Agriculture, Division of Water Resources
Application Number:

DEPTH OF COMPLETED WELL 155 ft. Bore Hole Diameter 1 7/8 in. to 11 in. to 11 in. to

Well Water to be used as:

5 Public water supply	8 Air conditioning	11 Injection well
1 Domestic	3 Feedlot	6 Oil field water supply
2 Irrigation	4 Industrial	9 Dewatering
7 Lawn and garden only	10 Observation well	<u>12 Other (Specify below)</u>

Research

Well's static water level 22.9 ft. below land surface measured on Jan month 28 day 1983 year

Pump Test Data



TYPE OF BLANK CASING USED:

1 Steel	3 RMP (SR)	5 Wrought iron	8 Concrete tile	Casing Joints: Glued <u>X</u> Clamped
<u>2 PVC</u>	4 ABS	6 Asbestos-Cement	9 Other (specify below)	Welded
		7 Fiberglass		Threaded


Casing height above land surface 12 in. weight 12 lbs./ft. Wall thickness or gauge No. 54 (Schedule 40) 1/2 in.

TYPE OF SCREEN OR PERFORATION MATERIAL:

1 Steel	3 Stainless steel	5 Fiberglass	8 RMP (SR)	10 Asbestos-cement
2 Brass	4 Galvanized steel	6 Concrete tile	9 ABS	11 Other (specify)
				12 None used (open hole)

Screen or Perforation Openings Are:

1 Continuous slot	<u>3</u> Mill slot	5 Gauzed wrapped	8 Saw cut	11 None (open hole)
2 Louvered shutter	4 Key punched	6 Wire wrapped	9 Drilled holes	
		7 Torch cut	10 Other (specify)	




GROUT MATERIAL: 1 Neat cement 2 Cement grout 3 Bentonite 4 Other


What is the nearest source of possible contamination:

1 Septic tank	4 Cess pool	7 Sewage lagoon	10 Fuel storage	14 Abandoned water well
2 Sewer lines	5 Seepage pit	8 Feed yard	11 Fertilizer storage	15 Oil well/Gas well
3 Lateral lines	6 Pit privy	9 Livestock pens	12 Insecticide storage	16 Other (specify below)
			13 Watertight sewer lines	









LOCATE WELL'S LOCATION WITH AN "X" IN SECTION BOX:	FROM	TO	LITHOLOGIC LOG	FROM	TO	LITHOLOGIC LOG
	0	14	reddish-brown silty sandy clay	99	120	sand interbedded with sandy clay
	14	28	fine to med. grained sand			
	28	32	reddish-brown sandy clay	120	125	clay interbedded with sand
	32	35	sand and gravel interbedded with thin clay layers	125	127	sand and gravel
	35	37	reddish-brown silty clay	127	148	gray-brown silty clay
	37	41	sand and gravel	148	155	sand and gravel
	41	49	gray-brown sandy clay interbedded with sand			
	49	94	sand and gravel			
	94	99	brown clay, slightly sandy			

ELEVATION: 1759.6



(Use a second sheet if needed)

INSTRUCTIONS: Use typewriter or ball point pen, please press firmly and PRINT clearly. Please fill in blanks, underline or circle the correct answers. Send top three copies to Kansas Department of Health and Environment, Division of Environment, Water Well Contractors, Topeka, KS 66620. Send one to WATER WELL OWNER and retain one for your records

SITE NUMBER : 35 (KPIQ)
SITE LOCATION : SW SW SW
LEGAL LOCATION: 31-26-10W
COUNTY : RENO

LANDOWNER: MRS. CHARLES HANSEN
ADDRESS : C/O BILL SCHAEFER
8633 W. 90TH TERRACE
PHONE NO.: OVERLAND-PARK, KS 66212
(913)-649-8633

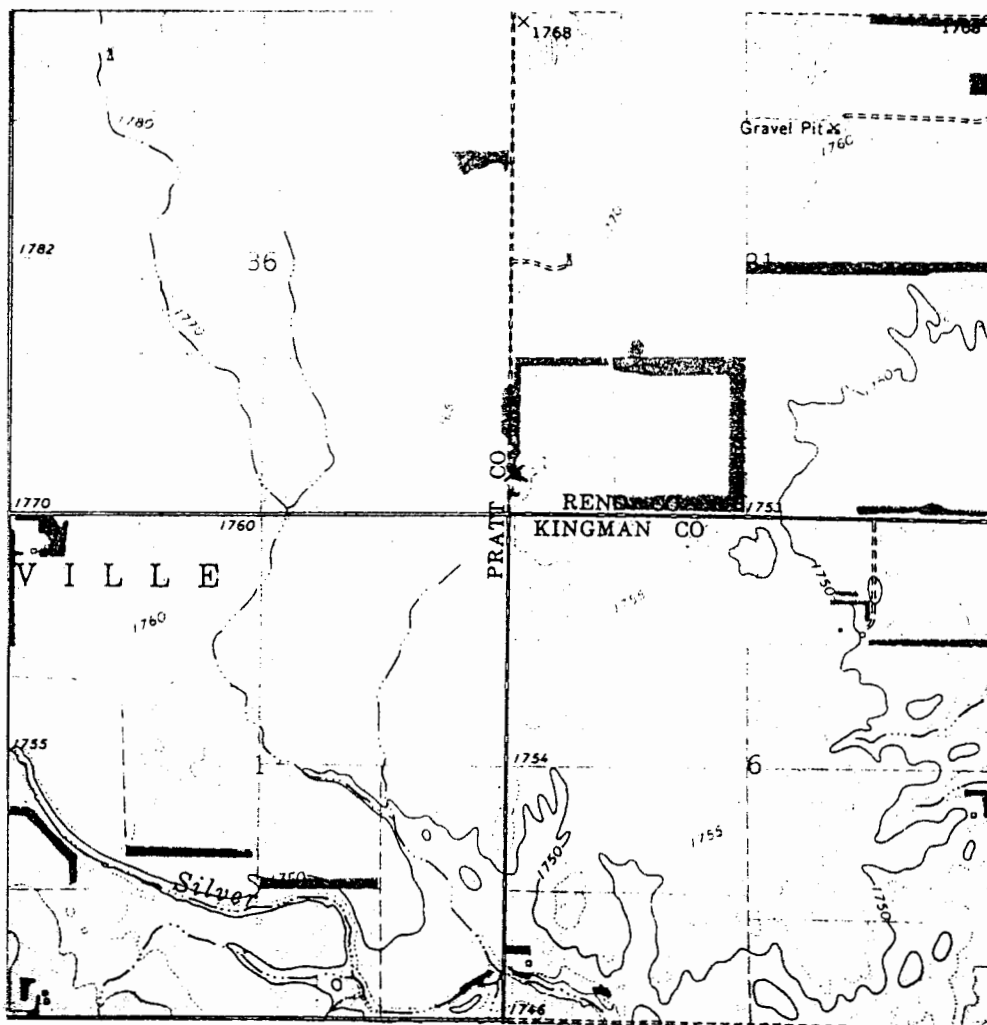

WELL LOCATION X

BIG BEND GMD#5-KGS
WATER QUALITY
OBSERVATION WELL
NETWORK

SITE NUMBER : 35 (KP10)
SITE LOCATION: SW SW SW

LEGAL LOCATION: 31-26-10W
COUNTY : RENO

WELL LOG

[illegible]