


Well ID

Revised 7/10/2015

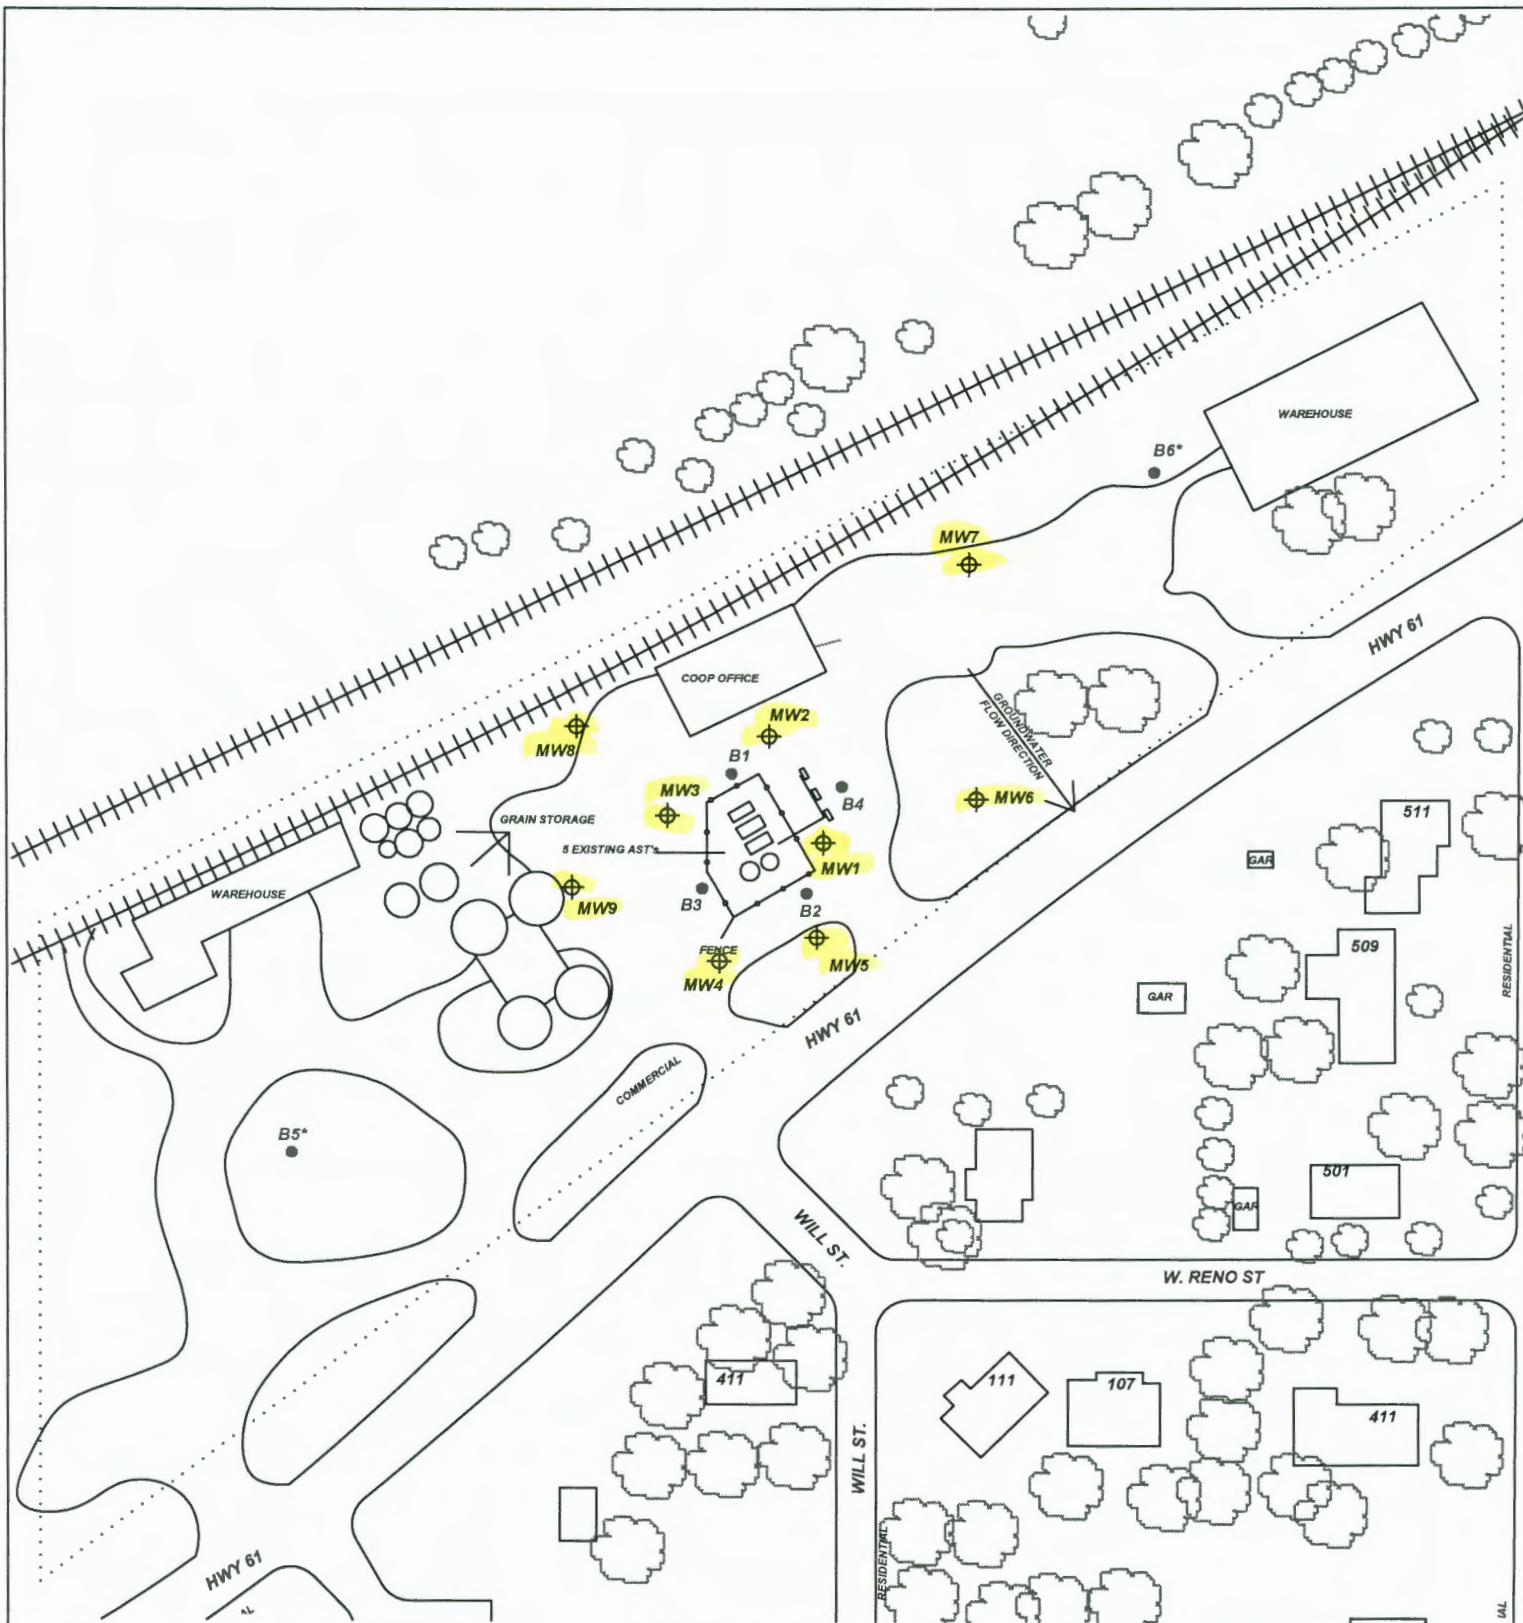

PROJECT: **TURON CARDTROL**

ADDRESS: **112 W HWY 61**

LOCATION: **TURON, KS**

DRAWN BY: **B. STALNAKER** DATE: **10/10/18**

REVISED BY: **B. STALNAKER** DATE: **1/24/19**

AEI JOB #: **TM242** KDHE JOB #: **A2-078-40488**

TITLE:

**FIGURE 2.2
AREA BASE MAP
350' RADIUS**



**ASSOCIATED
ENVIRONMENTAL
INC.**

LEGEND:

- = CURRENT PUMP ISLANDS
- = PROPOSED MONITORING WELL
- = PROPOSED SOIL BORING
- = SUBJECT PROPERTY



SCALE: **1" = 100'**



0 50 100

NOTES: * = Indicates boring for unsaturated and saturated zone hydrologic data.
No basements observed within 500'.

RECEIVED

FEB 26 2019

BUREAU OF WATER