

# WATER WELL RECORD Form WWC-5

☐ Original Record ☐ Correction ☐ Change in Well Use

Division of Water  
Resources App. No.

Well ID

MW5

<b>1 LOCATION OF WATER WELL:</b> County: <b>RENO</b>		<b>Fraction</b> SW 1/4 SE 1/4 NE 1/4 SE 1/4		<b>Section Number</b> 5	<b>Township Number</b> T 26S S	<b>Range Number</b> R 10 <input type="checkbox"/> E <input checked="" type="checkbox"/> W
<b>2 WELL OWNER:</b> Last Name: <b>KDHE-BER</b> Business: <b>KDHE-BER</b> Address: <b>1000 SW JACKSON</b> Address: City: <b>TOPEKA</b> State: <b>KS</b> ZIP: <b>66612-1367</b>			Street or Rural Address where well is located (if unknown, distance and direction from nearest town or intersection): If at owner's address, check here: <input type="checkbox"/> <b>112 W. HWY 61, TURON, KS</b>			
<b>3 LOCATE WELL WITH "X" IN SECTION BOX:</b> N <div style="border: 1px solid black; width: 100px; height: 100px; position: relative; margin: 10px auto;"><div style="position: absolute; top: 0; left: 0; width: 100%; height: 100%; border: 1px solid black; border-style: dashed;"></div><div style="position: absolute; top: 50%; left: 50%; transform: translate(-50%, -50%); font-size: 2em;">X</div></div> S W E		<b>4 DEPTH OF COMPLETED WELL:</b> ..... 35 ..... ft. Depth(s) Groundwater Encountered: 1) ..... 24 ..... ft. 2) ..... ft. 3) ..... ft., or 4) <input type="checkbox"/> Dry Well WELL'S STATIC WATER LEVEL: ..... 23.48 ..... ft. <input checked="" type="checkbox"/> below land surface, measured on (mo-day-yr) ..... 1/23/19 ..... <input type="checkbox"/> above land surface, measured on (mo-day-yr) ..... Pump test data: Well water was ..... ft. after ..... hours pumping ..... gpm Well water was ..... ft. after ..... hours pumping ..... gpm Estimated Yield: ..... gpm Bore Hole Diameter: ..... 8.5 ..... in. to ..... 35 ..... ft. and ..... in. to ..... ft.		<b>5 Latitude:</b> ..... 37.81027 ..... (decimal degrees) <b>Longitude:</b> ..... 98.43038 ..... (decimal degrees) <b>Horizontal Datum:</b> <input checked="" type="checkbox"/> WGS 84 <input type="checkbox"/> NAD 83 <input type="checkbox"/> NAD 27 <b>Source for Latitude/Longitude:</b> <input type="checkbox"/> GPS (unit make/model: .....) (WAAS enabled? <input type="checkbox"/> Yes <input type="checkbox"/> No) <input checked="" type="checkbox"/> Land Survey <input type="checkbox"/> Topographic Map <input type="checkbox"/> Online Mapper: .....		
		<b>6 Elevation:</b> ..... 1752.31 ..... ft. <input type="checkbox"/> Ground Level <input checked="" type="checkbox"/> TOC <b>Source:</b> <input checked="" type="checkbox"/> Land Survey <input type="checkbox"/> GPS <input type="checkbox"/> Topographic Map <input type="checkbox"/> Other .....				

**7 WELL WATER TO BE USED AS:**

1. Domestic: <input type="checkbox"/> Household <input type="checkbox"/> Lawn & Garden <input type="checkbox"/> Livestock 2. <input type="checkbox"/> Irrigation 3. <input type="checkbox"/> Feedlot 4. <input type="checkbox"/> Industrial	5. <input type="checkbox"/> Public Water Supply: well ID ..... 6. <input type="checkbox"/> Dewatering: how many wells? ..... 7. <input type="checkbox"/> Aquifer Recharge: well ID ..... 8. <input checked="" type="checkbox"/> Monitoring: well ID <b>MW5</b> 9. Environmental Remediation: well ID ..... <input type="checkbox"/> Air Sparge <input type="checkbox"/> Soil Vapor Extraction <input type="checkbox"/> Recovery <input type="checkbox"/> Injection	10. <input type="checkbox"/> Oil Field Water Supply: lease ..... 11. Test Hole: well ID ..... <input type="checkbox"/> Cased <input type="checkbox"/> Uncased <input type="checkbox"/> Geotechnical 12. Geothermal: how many bores? ..... a) Closed Loop <input type="checkbox"/> Horizontal <input type="checkbox"/> Vertical b) Open Loop <input type="checkbox"/> Surface Discharge <input type="checkbox"/> Inj. of Water 13. <input type="checkbox"/> Other (specify): .....
---	--	---

**Was a chemical/bacteriological sample submitted to KDHE?** ☐ Yes ☐ No If yes, date sample was submitted: .....  
**Water well disinfected?** ☐ Yes ☐ No

**8 TYPE OF CASING USED:** ☐ Steel ☒ PVC ☐ Other ..... **CASING JOINTS:** ☐ Glued ☐ Clamped ☐ Welded ☒ Threaded  
 Casing diameter ..... 2 ..... in. to ..... 35 ..... ft., Diameter ..... in. to ..... ft., Diameter ..... in. to ..... ft.  
 Casing height above land surface ..... in. Weight ..... lbs./ft. Wall thickness or gauge No. ....

**TYPE OF SCREEN OR PERFORATION MATERIAL:**  
☐ Steel ☐ Stainless Steel ☐ Fiberglass ☒ PVC ☐ Other (Specify) .....  
☐ Brass ☐ Galvanized Steel ☐ Concrete tile ☐ None used (open hole)

**SCREEN OR PERFORATION OPENINGS ARE:**  
☐ Continuous Slot ☒ Mill Slot ☐ Gauze Wrapped ☐ Torch Cut ☐ Drilled Holes ☐ Other (Specify) .....  
☐ Louvered Shutter ☐ Key Punched ☐ Wire Wrapped ☐ Saw Cut ☐ None (Open Hole)

**SCREEN-PERFORATED INTERVALS:** From ..... 20 ..... ft. to ..... 35 ..... ft., From ..... ft. to ..... ft., From ..... ft. to ..... ft.  
**GRAVEL PACK INTERVALS:** From ..... 18 ..... ft. to ..... 35 ..... ft., From ..... ft. to ..... ft., From ..... ft. to ..... ft.


**9 GROUT MATERIAL:** ☐ Neat cement ☐ Cement grout ☒ Bentonite ☒ Other **Concrete Surface Completion 0 -1**  
 Grout Intervals: From ..... 0 ..... ft. to ..... 1 ..... ft., From ..... 1 ..... ft. to ..... 18 ..... ft., From ..... ft. to ..... ft.

**Nearest source of possible contamination:**  
☐ Septic Tank ☐ Lateral Lines ☐ Pit Privy ☐ Livestock Pens ☐ Insecticide Storage  
☐ Sewer Lines ☐ Cess Pool ☐ Sewage Lagoon ☒ Fuel Storage ☐ Abandoned Water Well  
☐ Watertight Sewer Lines ☐ Seepage Pit ☐ Feedyard ☐ Fertilizer Storage ☐ Oil Well/Gas Well  
☐ Other (Specify) .....  
 Direction from well? ..... Distance from well? ..... ft.

10 FROM	TO	LITHOLOGIC LOG	FROM	TO	LITHO. LOG (cont.) or PLUGGING INTERVALS
0	1	TOPSOIL			
1	10	SILTY CLAY			
10	35	SAND			

**Notes:**

**11 CONTRACTOR'S OR LANDOWNER'S CERTIFICATION:** This water well was ☒ constructed, ☐ reconstructed, or ☐ plugged under my jurisdiction and was completed on (mo-day-year) **1/22/19** ..... and this record is true to the best of my knowledge and belief.  
 Kansas Water Well Contractor's License No. **585** ..... This Water Well Record was completed on (mo-day-year) **2/8/19** .....  
 under the business name of **ASSOCIATED ENVIRONMENTAL INC.** Signature *[Signature]*

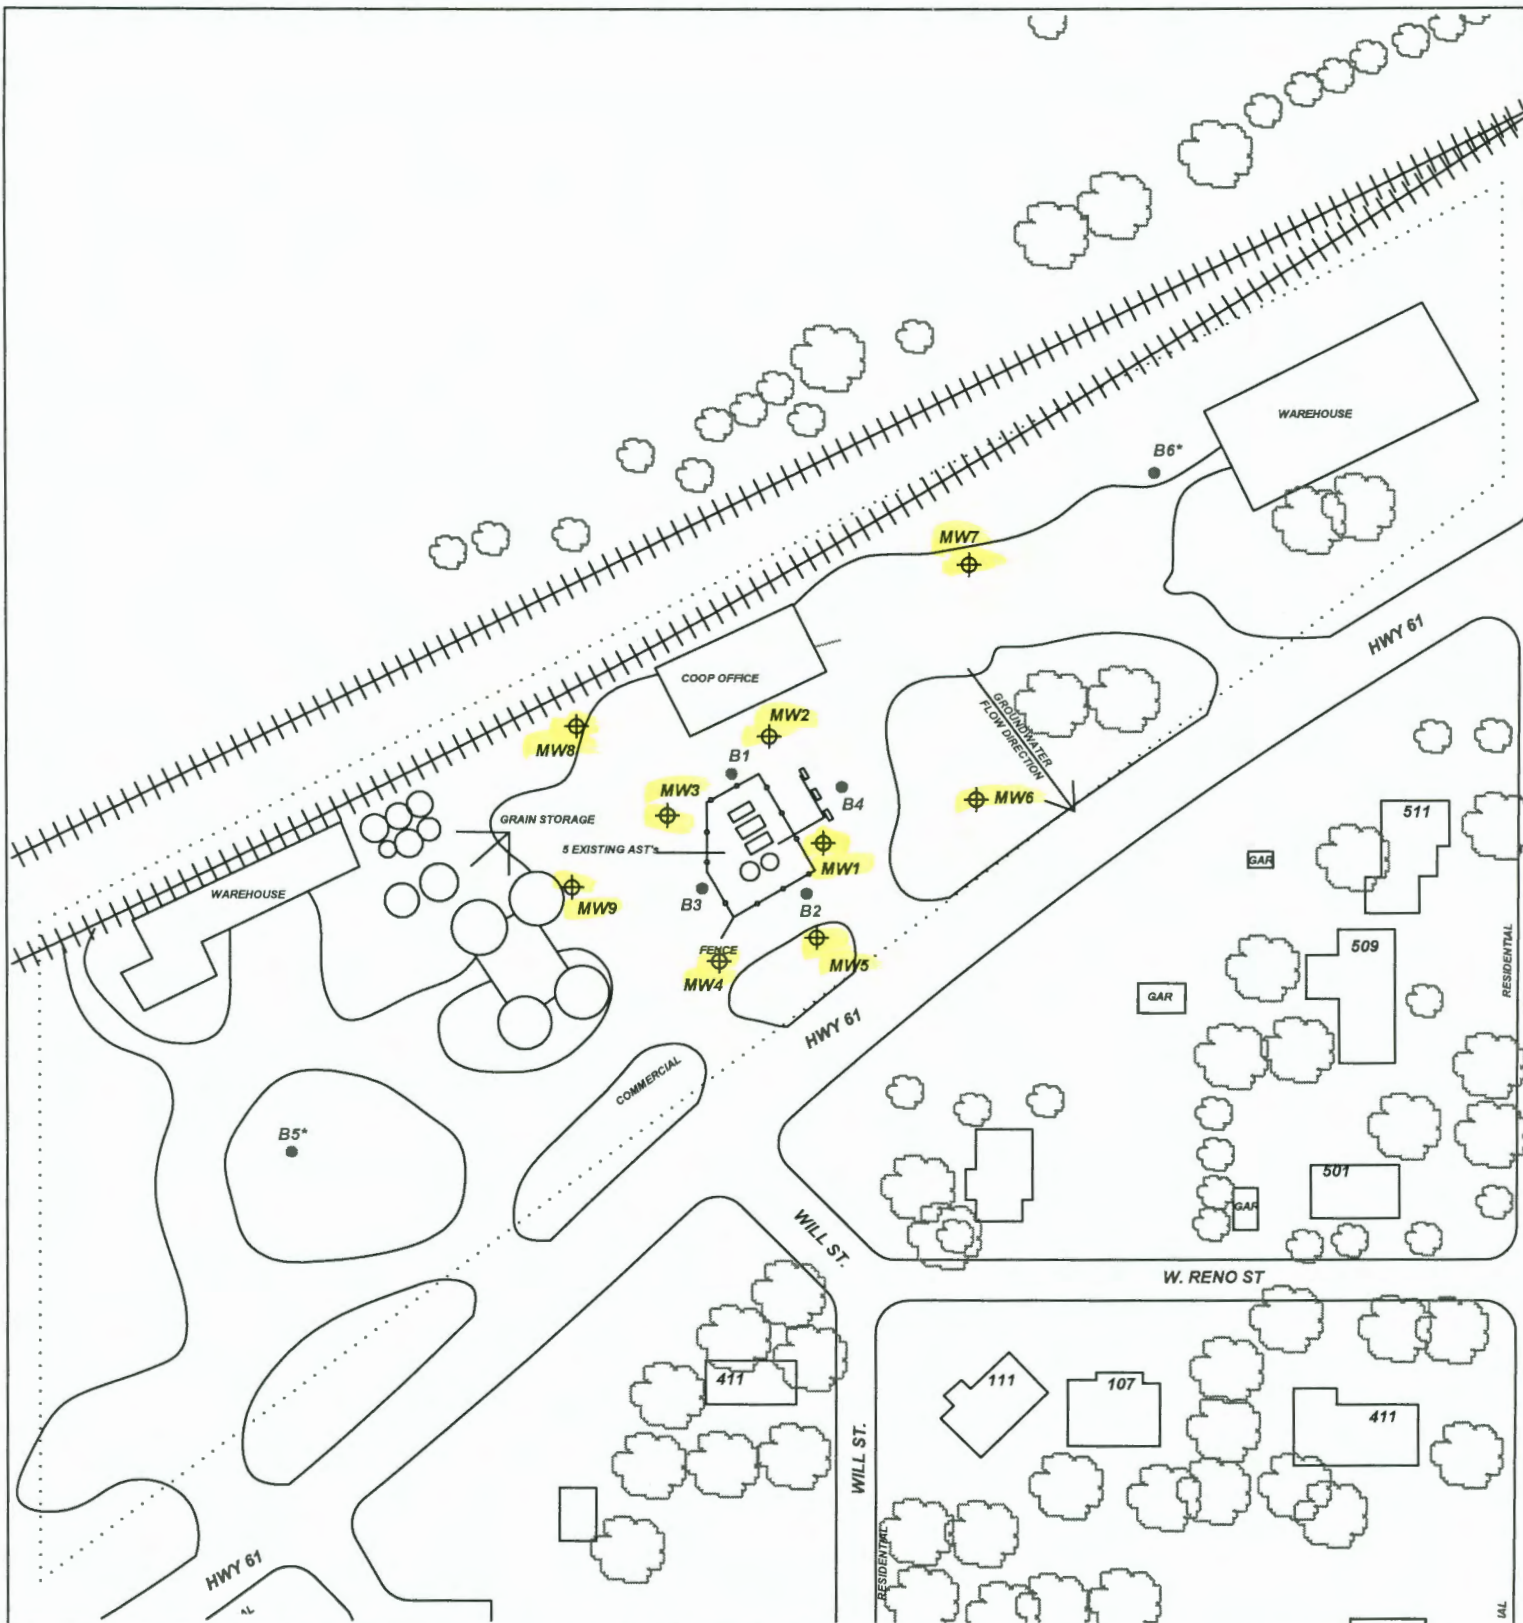

PROJECT: **TURON CARDTROL**

ADDRESS: **112 W HWY 61**

LOCATION: **TURON, KS**

DRAWN BY: **B. STALNAKER** DATE: **10/10/18**

REVISED BY: **B. STALNAKER** DATE: **1/24/19**

AEI JOB #: **TM242** KDHE JOB #: **A2-078-40488**

SCALE: **1" = 100'**  
  
 0 50 100

NOTES: \* = Indicates boring for unsaturated and saturated zone hydrologic data.  
 No basements observed within 500'.

TITLE:

**FIGURE 2.2  
 AREA BASE MAP  
 350' RADIUS**



**ASSOCIATED  
 ENVIRONMENTAL  
 INC.**

LEGEND:

- = CURRENT PUMP ISLANDS
- = PROPOSED MONITORING WELL
- = PROPOSED SOIL BORING
- = SUBJECT PROPERTY



**RECEIVED**

**FEB 26 2019**

**BUREAU OF WATER**