


☐ Original Record ☐ Correction ☐ Change in Well Use

MW8

Well ID

[illegible]

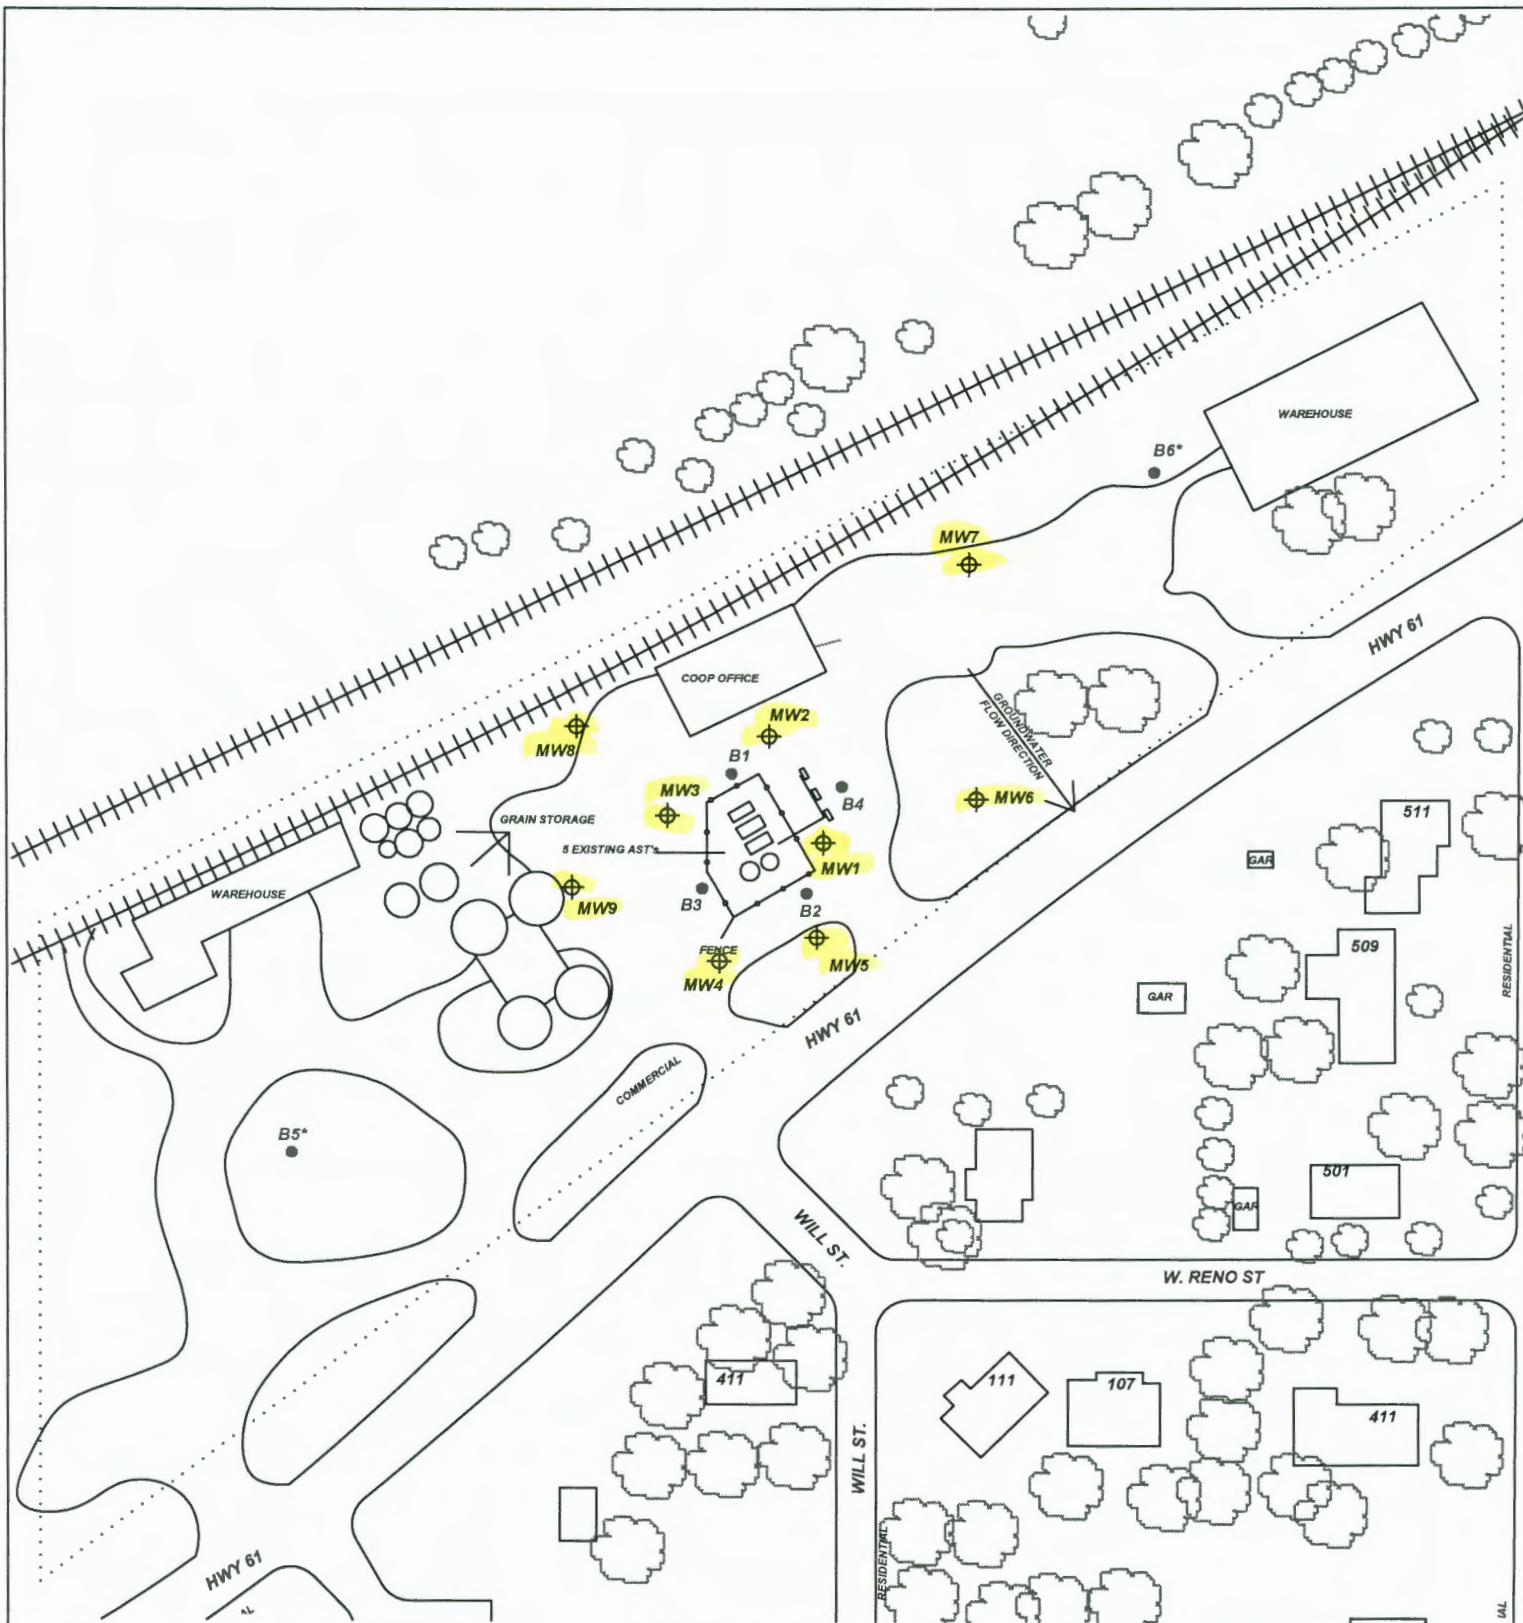

PROJECT: TURON CARDTROL		TITLE: FIGURE 2.2 AREA BASE MAP 350' RADIUS		LEGEND: = CURRENT PUMP ISLANDS = PROPOSED MONITORING WELL = PROPOSED SOIL BORING = SUBJECT PROPERTY	
ADDRESS: 112 W HWY 61		ASSOCIATED ENVIRONMENTAL INC.		<div style="text-align: center;"> </div> <div style="text-align: center;"> RECEIVED FEB 26 2019 BUREAU OF WATER </div>	
LOCATION: TURON, KS					
DRAWN BY: B. STALNAKER DATE: 10/10/18					
REVISED BY: B. STALNAKER DATE: 1/24/19					
AEI JOB #: TM242 KDHE JOB #: A2-078-40488					
SCALE: 1" = 100' 		NOTES: * = Indicates boring for unsaturated and saturated zone hydrologic data. No basements observed within 500'.			