


MV9

☐ Original Record ☐ Correction ☐ Change in Well Use

Well ID

[illegible]

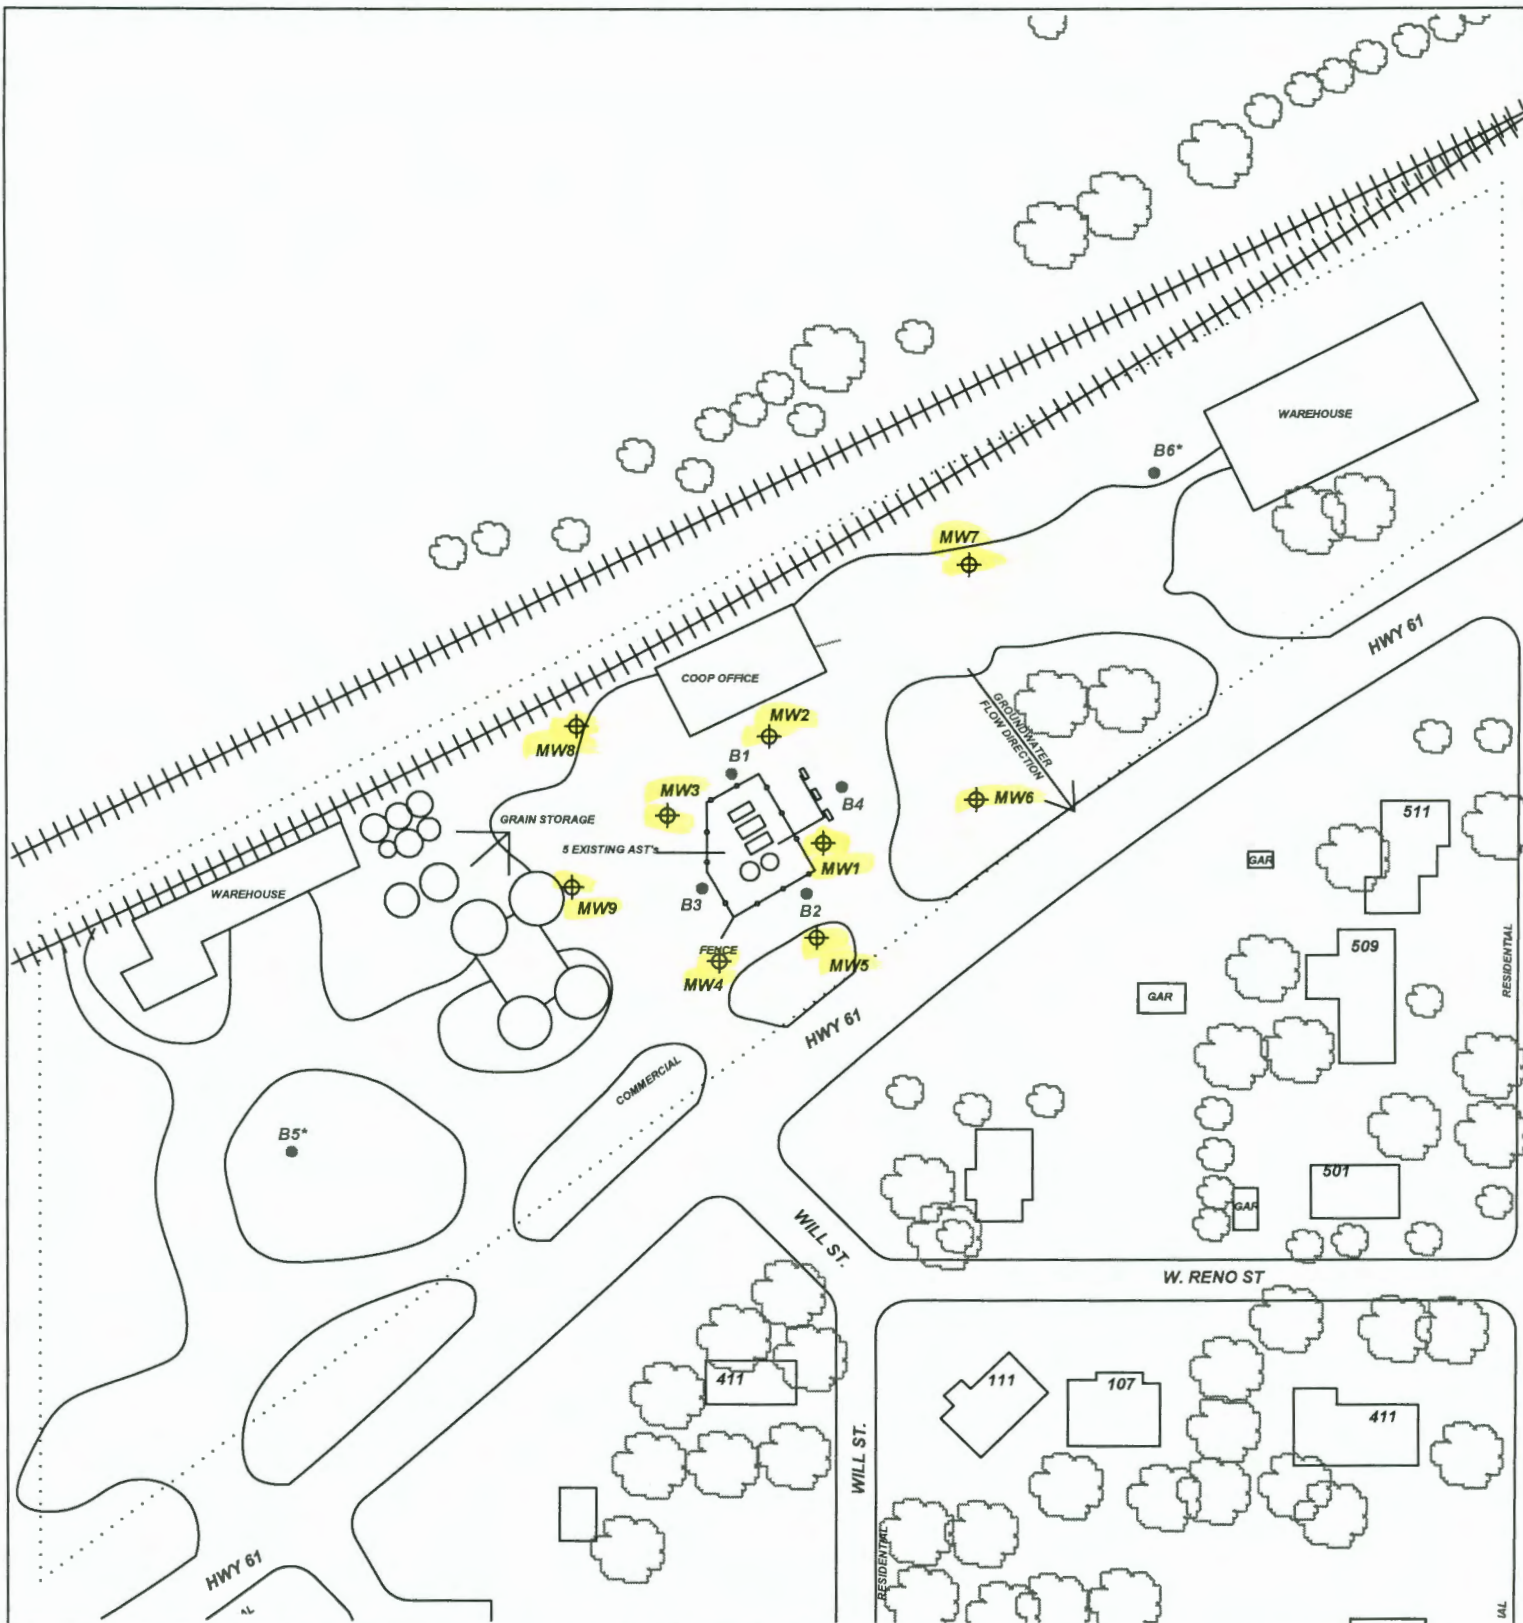

PROJECT: **TURON CARDTROL**

ADDRESS: **112 W HWY 61**

LOCATION: **TURON, KS**

DRAWN BY: **B. STALNAKER** DATE: **10/10/18**

REVISED BY: **B. STALNAKER** DATE: **1/24/19**

AEI JOB #: **TM242** KDHE JOB #: **A2-078-40488**

SCALE: **1" = 100'**

 0 50 100

NOTES: * = Indicates boring for unsaturated and saturated zone hydrologic data.
 No basements observed within 500'.

TITLE:

**FIGURE 2.2
 AREA BASE MAP
 350' RADIUS**



**ASSOCIATED
 ENVIRONMENTAL
 INC.**

LEGEND:

- = CURRENT PUMP ISLANDS
- = PROPOSED MONITORING WELL
- = PROPOSED SOIL BORING
- = SUBJECT PROPERTY



RECEIVED

FEB 26 2019

BUREAU OF WATER