


**Form WWC-5**


☒ Original Record    ☐ Correction    ☐ Change in Well Use

Division of Water  
Resources App. No.

Well ID	MW11
---------	------

[illegible]

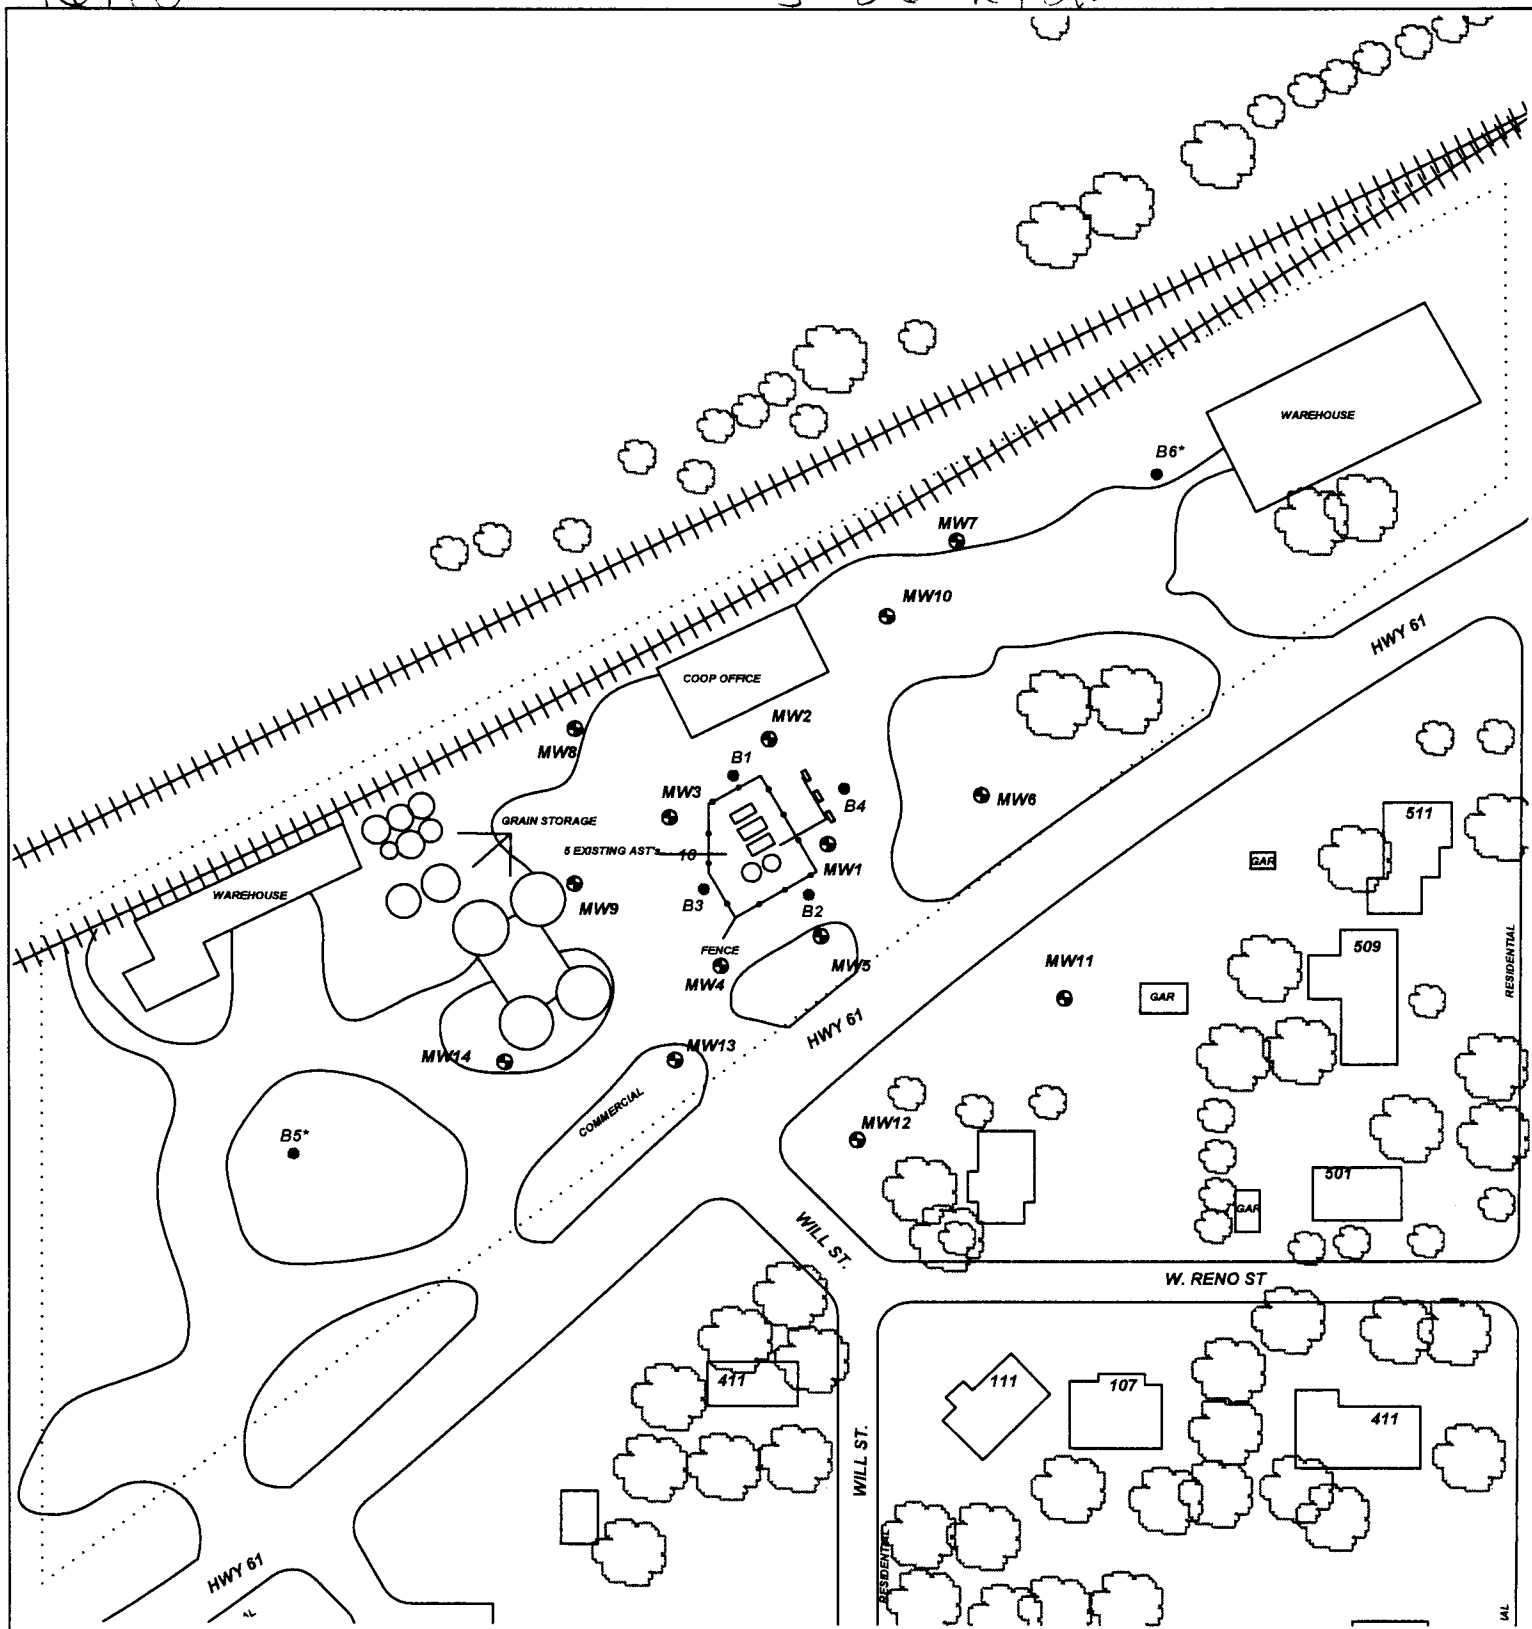

<b>PROJECT:</b> TURON CARDTROL		<b>TITLE:</b>   <b>ASSOCIATED ENVIRONMENTAL INC.</b>	<b>LEGEND:</b> ☐ = CURRENT PUMP ISLANDS ● = MONITORING WELL ● = PROPOSED SOIL BORING ..... = SUBJECT PROPERTY
<b>ADDRESS:</b> 112 W HWY 61			
<b>LOCATION:</b> TURON, KS			
<b>DRAWN BY:</b> B. STALNAKER <b>DATE:</b> 10/10/18			
<b>REVISED BY:</b> B. STALNAKER <b>DATE:</b> 3/19/19			
<b>AEI JOB #:</b> TM242 <b>KDHE JOB #:</b> A2-078-40488			
<b>SCALE:</b> 1" = 100' 