

NE $\frac{1}{4}$ NE $\frac{1}{4}$ NE $\frac{1}{4}$


BIG BEND GMD#5-KGS
WATER QUALITY
OBSERVATION WELL
NETWORK


SITE NUMBER : 39 (KP14)
SITE LOCATION: NE NE NE

LEGAL LOCATION: 1-26-10W
COUNTY : RENO


WELL LOG

FROM	TO	LITHOLOGIC LOG	OWNER: RAILSBACK
0	4	dark brown topsoil	
4	7	orange-brown sandy clay becoming dark grey silty clay	
7	20	sand and gravel, some sandy clay at top	
20	33	yellowish tan silty clay, becoming very sticky	
33	58 55	sand and gravel	
58 55	78	red shale--PERMIAN	

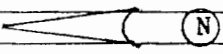


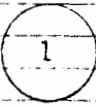

TD=78'
73'/5'

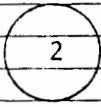


TD=58'
53'/5'

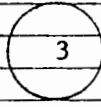

TD=20'
15'/5'

SITE NUMBER : 39 (KP14)
SITE LOCATION : NE NE NE
LEGAL LOCATION: 1-26-10W
COUNTY : RENO

Bill Bradshaw
LANDOWNER: Ned Railsback
ADDRESS : Rt. 1
Langdon, KS
PHONE NO.: (316)-596-2526

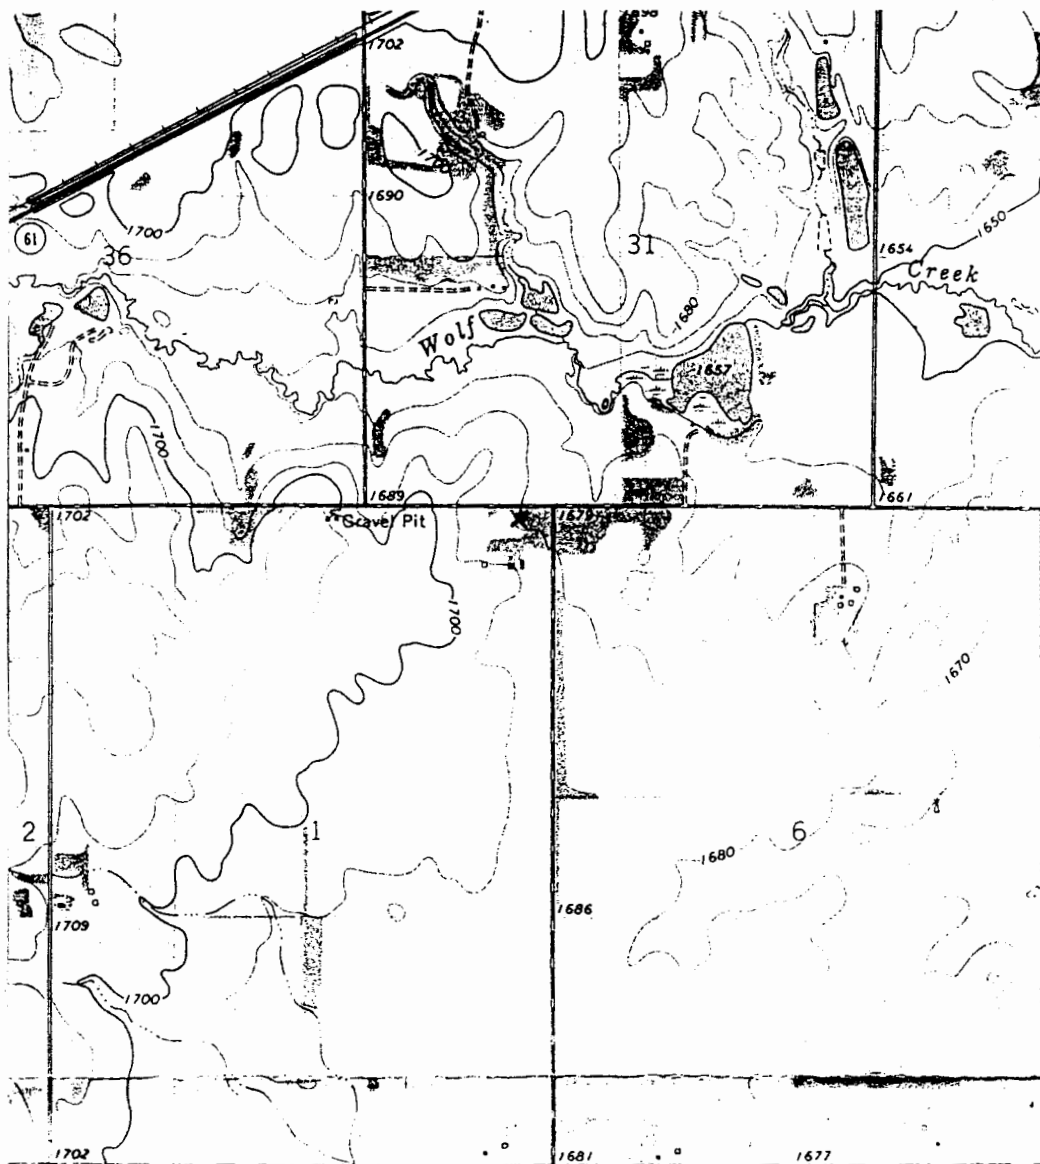

WELL LOCATION X