


1 LOCATION OF WATER WELL: County: **PRATT** Fraction: **SW 1/4 NW 1/4 NW 1/4** Section Number: **29** Township Number: **T 26 S** Range Number: **R 11 EW**

Distance and direction from nearest town or city street address of well if located within city?  
**145' N. of Hooker ST centerline E 157' N of 5th ST. corner line, Preston, KS.**

2 WATER WELL OWNER: **MORGAN TRINATE**  
 RR#, St. Address, Box #: **RT 1 BOX 165**  
 City, State, ZIP Code: **PRESTON, KS 67569**  
 Board of Agriculture, Division of Water Resources  
 Application Number: **N/A**

3 LOCATE WELL'S LOCATION WITH AN "X" IN SECTION BOX: **X** in NW section  
 4 DEPTH OF COMPLETED WELL: **23.75'** ft. ELEVATION: **1832.78 TOC**  
 Depth(s) Groundwater Encountered: **1. 15-17** ft. 2. \_\_\_\_\_ ft. 3. \_\_\_\_\_ ft.

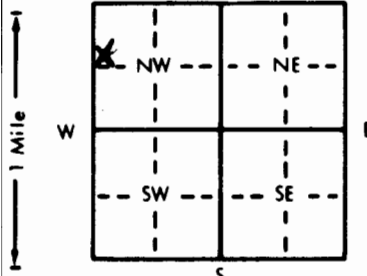

WELL'S STATIC WATER LEVEL: **14.53** ft. below land surface measured on mo/day/yr **10/17/95**  
 Pump test data: Well water was \_\_\_\_\_ ft. after \_\_\_\_\_ hours pumping \_\_\_\_\_ gpm  
 Est. Yield \_\_\_\_\_ gpm; Well water was \_\_\_\_\_ ft. after \_\_\_\_\_ hours pumping \_\_\_\_\_ gpm  
 Bore Hole Diameter: **7 7/8** in. to **23.75** ft., and \_\_\_\_\_ in. to \_\_\_\_\_ ft.  
 WELL WATER TO BE USED AS:  
 5 Public water supply 8 Air conditioning 11 Injection well  
 1 Domestic 3 Feedlot 6 Oil field water supply 9 Dewatering 12 Other (Specify below)  
 2 Irrigation 4 Industrial 7 Lawn and garden only **10 Monitoring well MW 5**  
 Was a chemical/bacteriological sample submitted to Department? Yes \_\_\_\_\_ No **X**; If yes, mo/day/yr sample was submitted \_\_\_\_\_  
 Water Well Disinfected? Yes \_\_\_\_\_ No **X**

5 TYPE OF BLANK CASING USED:  
 1 Steel 3 RMP (SR) 6 Asbestos-Cement 9 Other (specify below) Welded \_\_\_\_\_  
**2 PVC** 4 ABS 7 Fiberglass \_\_\_\_\_ Threaded **X**  
 Blank casing diameter: **2** in. to **13.5** ft., Dia \_\_\_\_\_ in. to \_\_\_\_\_ ft., Dia \_\_\_\_\_ in. to \_\_\_\_\_ ft.  
 Casing height above land surface: **-6** in., weight \_\_\_\_\_ lbs./ft. Wall thickness or gauge No. **Sch. 40**

TYPE OF SCREEN OR PERFORATION MATERIAL:  
 1 Steel 3 Stainless steel 5 Fiberglass 8 RMP (SR) 11 Other (specify) \_\_\_\_\_  
 2 Brass 4 Galvanized steel 6 Concrete tile 9 ABS 12 None used (open hole)

SCREEN OR PERFORATION OPENINGS ARE:  
 1 Continuous slot **3 Mill slot** 6 Wire wrapped 9 Drilled holes  
 2 Louvered shutter 4 Key punched 7 Torch cut 10 Other (specify) \_\_\_\_\_  
 5 Gauzed wrapped 8 Saw cut 11 None (open hole)

SCREEN-PERFORATED INTERVALS: From **13.5** ft. to **23.5** ft., From \_\_\_\_\_ ft. to \_\_\_\_\_ ft.  
 From \_\_\_\_\_ ft. to \_\_\_\_\_ ft., From \_\_\_\_\_ ft. to \_\_\_\_\_ ft.  
 GRAVEL PACK INTERVALS: From **11.5** ft. to **20.5** ft., From \_\_\_\_\_ ft. to \_\_\_\_\_ ft.  
 From \_\_\_\_\_ ft. to \_\_\_\_\_ ft., From \_\_\_\_\_ ft. to \_\_\_\_\_ ft.

6 GROUT MATERIAL: 1 Neat cement 2 Cement grout **3 Bentonite** 4 Other \_\_\_\_\_  
 Grout Intervals: From **1** ft. to **9.5** ft., From **9.5** ft. to **11.5** ft., From \_\_\_\_\_ ft. to \_\_\_\_\_ ft.

What is the nearest source of possible contamination:  
 1 Septic tank 4 Lateral lines 7 Pit privy **11 Fuel storage** 14 Abandoned water well  
 2 Sewer lines 5 Cess pool 8 Sewage lagoon 12 Fertilizer storage 15 Oil well/Gas well  
 3 Watertight sewer lines 6 Seepage pit 9 Feedyard 13 Insecticide storage 16 Other (specify below) **17 UST PIT**  
 Direction from well? **NW** How many feet? **115**

FROM	TO	LITHOLOGIC LOG	FROM	TO	PLUGGING INTERVALS
0'	1'	Topsoil, Brown, BLACK ORGANIC CLAY, BROWN, SANDY (F-M) CLAY, TAN, SANDY (F-M) CLAY, Red-Brown, SILTY, SANDY (F-M), Gravel Present, Caliche nodules Present			
1'	40'				
40'	70'				
70'	170'				
17.0	23.75	SAND, BROWN (F-C), well sorted wet 15-17 PGL			

7 CONTRACTOR'S OR LANDOWNER'S CERTIFICATION: This water well was **(1)** constructed, (2) reconstructed, or (3) plugged under my jurisdiction and was completed on (mo/day/year) **10/17/95** and this record is true to the best of my knowledge and belief. Kansas Water Well Contractor's License No. **483** This Water Well Record was completed on (mo/day/yr) **12-21-95** under the business name of **TEST** by (signature) **[Signature]**

OFFICE USE ONLY T R EW SEC.