

1 LOCATION OF WATER WELL:	Fraction	Section Number	Township Number	Range Number
County: <u>Pratt</u>	<u>NW 1/4 NE 1/4 NW 1/4</u>	<u>30</u>	<u>T 26 S</u>	<u>R 11 E/W</u>


Distance and direction from nearest town or city street address of well if located within city?

Approximately $\frac{1}{4}$ mile west of Preston

2 WATER WELL OWNER:	City of Preston	Board of Agriculture, Division of Water Resources
RR#, St. Address, Box # :	<u>500 Main Street</u>	Application Number:
City, State, ZIP Code :	<u>Preston, KS 67569</u>	

3 LOCATE WELL'S LOCATION WITH AN "X" IN SECTION BOX:

4 DEPTH OF COMPLETED WELL.....	<u>122</u> ft.	ELEVATION:	<u>unknown</u>
--------------------------------	----------------	------------------	----------------

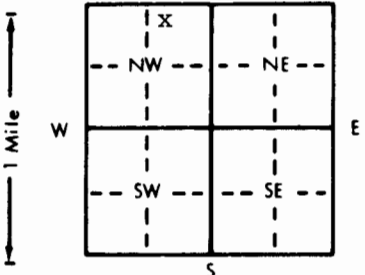

Depth(s) Groundwater Encountered 1. ft. 2. ft. 3. ft.

WELL'S STATIC WATER LEVEL 28 ft. below land surface measured on mo/day/yr 6-23-97

Pump test data: Well water was not ch'd ft. after hours pumping gpm

Est. Yield unknown gpm; Well water was ft. after hours pumping gpm

Bore Hole Diameter 10 in. to 138 ft., and in. to ft.

WELL WATER TO BE USED AS:

5 Public water supply	8 Air conditioning	11 Injection well
1 Domestic	3 Feedlot	6 Oil field water supply
2 Irrigation	4 Industrial	7 Lawn and garden only
		10 Monitoring well

Test Well

Was a chemical/bacteriological sample submitted to Department? Yes.....No.......... If yes, mo/day/yr sample was submitted

Water Well Disinfected? Yes.....No.....

5 TYPE OF CASING USED:	5 Wrought iron	8 Concrete tile	CASING JOINTS: Glued <input checked="" type="checkbox"/> Clamped
1 Steel	3 RMP (SR)	6 Asbestos-Cement	9 Other (specify below) Welded
2 PVC	4 ABS	7 Fiberglass	10 Asbestos-cement Threaded

Blank casing diameter 5 in. to 100 ft., Dia in. to ft., Dia in. to ft.

Casing height above land surface 24 in., weight 2.36 lbs./ft. Wall thickness or gauge No. 214

TYPE OF SCREEN OR PERFORATION MATERIAL:	7 PVC	10 Asbestos-cement	11 Other (specify)
1 Steel	3 Stainless steel	5 Fiberglass	8 RMP (SR)
2 Brass	4 Galvanized steel	6 Concrete tile	9 ABS
			12 None used (open hole)

SCREEN OR PERFORATION OPENINGS ARE:	5 Gauzed wrapped	8 Saw cut	11 None (open hole)
1 Continuous slot	3 Mill slot	6 Wire wrapped	9 Drilled holes
2 Louvered shutter	4 Key punched	7 Torch cut	10 Other (specify)

SCREEN-PERFORATED INTERVALS: From 100 ft. to 120 ft., From ft. to ft.

From ft. to ft., From ft. to ft.

GRAVEL PACK INTERVALS: From 25 ft. to 50 ft., From ft. to ft.

From 95 ft. to 125 ft., From ft. to ft.

6 GROUT MATERIAL:	1 Neat cement	2 Cement grout	3 Bentonite	4 Other <u>Bentonite Holeplug</u>
-------------------	---------------	----------------	-------------	-----------------------------------

Grout Intervals: From 0 ft. to 25 ft., From 50 ft. to 95 ft., From 125 ft. to 138 ft.

What is the nearest source of possible contamination:	10 Livestock pens	14 Abandoned water well	15 Oil well/Gas well
1 Septic tank	4 Lateral lines	7 Pit privy	11 Fuel storage
2 Sewer lines	5 Cess pool	8 Sewage lagoon	12 Fertilizer storage
3 Watertight sewer lines	6 Seepage pit	9 Feedyard	13 Insecticide storage
			16 Other (specify below)
			17 None known

Direction from well? How many feet?

FROM	TO	LITHOLOGIC LOG	FROM	TO	PLUGGING INTERVALS
0	3	Topsoil	92	100	Sand and gravel, medium, coarse
3	9	Clay, brown	100	122	Sand, fine, medium, clean, loose
9	10	Clay, sandy, sitly, fine	122	136	Sand and gravel, fine, medium
10	16	Sand, silty, fine	136	138	Clay, brown
16	23	Clay, brown			
23	33	Clay, brown to reddish			
33	38	Sand and gravel, fine, medium, coarse			
38	41	Clay, tan			
41	54	Clay, brown			
54	56	Sand and gravel, medium, coarse			
56	63	Sand nad gravel with clay stringer			
63	78	Clay, brown			
78	80	Sand and gravel, medium, coarse			
80	92	Clay, brown			

7 CONTRACTOR'S OR LANDOWNER'S CERTIFICATION:	This water well was (1) <u>constructed</u> , (2) <u>reconstructed</u> , or (3) <u>plugged</u> under my jurisdiction and was completed on (mo/day/year) <u>6-23-97</u> and this record is true to the best of my knowledge and belief. Kansas Water Well Contractor's License No. <u>185</u> This Water Well Record was completed on (mo/day/yr) <u>6-30-97</u> under the business name of <u>Clarke Well & Equipment, Inc.</u> by (signature) <i>Clarke</i>
----------------------------------------------	---