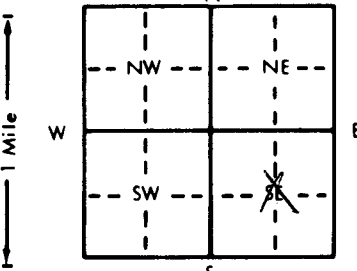


1 LOCATION OF WATER WELL: Fraction $\frac{1}{4}$ N/C $\frac{1}{4}$ SE $\frac{1}{4}$ Section Number 3 Township Number T 26 S Range Number R 11 ~~E~~W
 County: Pratt

Distance and direction from nearest town or city street address of well if located within city?
 $3\frac{1}{4}$ north, $2\frac{1}{4}$ east of Preston, Ks. WEST WELL

2 WATER WELL OWNER: Ken Jorns
 RR#, St. Address, Box #: 36114 W. Sun City Rd. Board of Agriculture, Division of Water Resources
 City, State, ZIP Code: Turon, Ks. 67583 Application Number:

3 LOCATE WELL'S LOCATION WITH AN "X" IN SECTION BOX:  4 DEPTH OF COMPLETED WELL: ~~XXX~~ 123 ft. ELEVATION:
 Depth(s) Groundwater Encountered 1. ft. 2. ft. 3. ft.
 WELL'S STATIC WATER LEVEL ... 40 ... ft. below land surface measured on mo/day/yr ... 7-14-97
 Pump test data: Well water was ft. after hours pumping gpm
 Est. Yield ... n.a. ... gpm: Well water was ft. after hours pumping gpm
 Bore Hole Diameter ... 5 ... in. to ... 12.4 ... ft., and ... in. to ... ft.
 WELL WATER TO BE USED AS: 5 Public water supply 8 Air conditioning 11 Injection well
 1 Domestic 3 Feedlot 6 Oil field water supply 9 Dewatering 12 Other (Specify below)
 2 Irrigation 4 Industrial 7 Lawn and garden only 10 Monitoring well
 Was a chemical/bacteriological sample submitted to Department? Yes No ; If yes, mo/day/yr sample was submitted
 Water Well Disinfected? Yes No

5 TYPE OF BLANK CASING USED: 5 Wrought iron 8 Concrete tile CASING JOINTS: Glued Clamped
 1 Steel 3 RMP (SR) 6 Asbestos-Cement 9 Other (specify below) Welded
 2 PVC 4 ABS 7 Fiberglass Threaded
 Blank casing diameter ... $2\frac{1}{2}$... in. to ... 1.18 ... ft., Dia in. to ft., Dia in. to ft.
 Casing height above land surface ... 2' ... in., weight ... SDR 26 ... lbs./ft. Wall thickness or gauge No.
 TYPE OF SCREEN OR PERFORATION MATERIAL: 7 PVC 10 Asbestos-cement
 1 Steel 3 Stainless steel 5 Fiberglass 8 RMP (SR) 11 Other (specify)
 2 Brass 4 Galvanized steel 6 Concrete tile 9 ABS 12 None used (open hole)
 SCREEN OR PERFORATION OPENINGS ARE: 5 Gauzed wrapped 8 Saw cut 11 None (open hole)
 1 Continuous slot 3 Mill slot 6 Wire wrapped 9 Drilled holes
 2 Louvered shutter 4 Key punched 7 Torch cut 10 Other (specify)
 SCREEN-PERFORATED INTERVALS: From ... 123 ... ft. to ... 118 ... ft., From ft. to ft.
 From ft. to ft., From ft. to ft.
 GRAVEL PACK INTERVALS: From ... 124 ... ft. to ... 20 ... ft., From ft. to ft.
 From ft. to ft., From ft. to ft.

6 GROUT MATERIAL: 1 Neat cement 2 Cement grout 3 Bentonite 4 Other hole plug
 Grout Intervals: From ... 20 ... ft. to ... 0 ... ft., From ft. to ft., From ft. to ft.
 What is the nearest source of possible contamination:
 1 Septic tank 4 Lateral lines 7 Pit privy 10 Livestock pens 14 Abandoned water well
 2 Sewer lines 5 Cess pool 8 Sewage lagoon 11 Fuel storage 15 Oil well/Gas well
 3 Watertight sewer lines 6 Seepage pit 9 Feedyard 12 Fertilizer storage 16 Other (specify below)
 13 Insecticide storage none

Direction from well? How many feet?

FROM	TO	LITHOLOGIC LOG	FROM	TO	PLUGGING INTERVALS
0	3	Top soil			
3	5	Brown clay			
5	19	Light brown clay			
19	36	Fine sand			
36	38	White valcano ash			
38	43	Fine sand			
43	57	Brown clay			
57	63	Sand and gravel clean medium loose			
63	73	Brown clay			
73	77	Sand and gravel medium loose			
77	79	Brown clay			
79	90	Sand and gravel clean medium loose			
90	100	Yellow brown clay			
100	123	Sand and gravel			
123	124	Brown & gray clay			

7 CONTRACTOR'S OR LANDOWNER'S CERTIFICATION: This water well was (1) constructed, (2) reconstructed, or (3) plugged under my jurisdiction and was completed on (mo/day/year) ... 7-15-97 ... and this record is true to the best of my knowledge and belief. Kansas Water Well Contractor's License No. ... 134 ... This Water Well Record was completed on (mo/day/yr) ... 7-21-97 ... under the business name of Rosencrantz-Bemis by (signature) Fredia Redson

OFFICE USE ONLY
T
R
EW
SEC.