


1 LOCATION OF WATER WELL:	Fraction	Section Number	Township Number	Range Number
County: Pratt	1/4 NC 1/4 NW 1/4	9	T 26 S	R 11 EW

Distance and direction from nearest town or city street address of well if located within city?
 Approximately 2 3/4 miles north and 1 1/2 miles east of Preston

2 WATER WELL OWNER: Norman Hildebrand
 RR#, St. Address, Box #: Route 1
 City, State, ZIP Code: Stafford, KS 67578
 Board of Agriculture, Division of Water Resources
 Application Number:

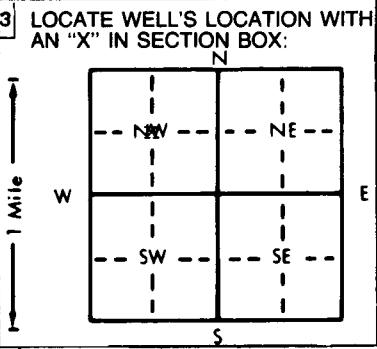

4 DEPTH OF COMPLETED WELL: 149.5 ft. ELEVATION: unknown
 Depth(s) Groundwater Encountered 1. ft. 2. ft. 3. ft.
 WELL'S STATIC WATER LEVEL: 36.5 ft. below land surface measured on mo/day/yr 5-4-99
 Pump test data: Well water was not ch'd. ft. after hours pumping gpm
 Est. Yield unknown gpm: Well water was ft. after hours pumping gpm
 Bore Hole Diameter: 7 in. to 148 in. to in. to in. to ft.
 WELL WATER TO BE USED AS:
 5 Public water supply 8 Air conditioning 11 Injection well
 1 Domestic 3 Feedlot 6 Oil field water supply 9 Dewatering 12 Other (Specify below)
 2 Irrigation 4 Industrial 7 Lawn and garden only 10 Monitoring well Observation Well
 Was a chemical/bacteriological sample submitted to Department? Yes No If yes, mo/day/yr sample was sub-
 mitted Water Well Disinfected? Yes No

5 TYPE OF BLANK CASING USED:
 1 Steel 3 RMP (SR) 5 Wrought iron 8 Concrete tile CASING JOINTS: Glued Clamped
 2 PVC 4 ABS 6 Asbestos-Cement 9 Other (specify below) Welded
 7 Fiberglass Threaded
 Blank casing diameter 3 in. to 125 ft. Dia 3 in. to 147 ft. Dia in. to ft.
 Casing height above land surface 30 in., weight 1.96 lbs./ft. Wall thickness or gauge No. 300
 TYPE OF SCREEN OR PERFORATION MATERIAL:
 1 Steel 3 Stainless steel 5 Fiberglass 8 RMP (SR) 10 Asbestos-cement
 2 Brass 4 Galvanized steel 6 Concrete tile 9 ABS 11 Other (specify)
 12 None used (open hole)
 SCREEN OR PERFORATION OPENINGS ARE:
 5 Gauzed wrapped 8 Saw cut 11 None (open hole)
 1 Continuous slot 3 Mill slot 6 Wire wrapped 9 Drilled holes
 2 Louvered shutter 4 Key punched 7 Torch cut 10 Other (specify)
 SCREEN-PERFORATED INTERVALS: From 125 ft. to 130 ft. From ft. to ft.
 From ft. to ft. From ft. to ft.
 GRAVEL PACK INTERVALS: From 123 ft. to 148 ft. From ft. to ft.
 From ft. to ft. From ft. to ft.

6 GROUT MATERIAL: 1 Neat cement 2 Cement grout 3 Bentonite 4 Other Bentonite Holeplug
 Grout Intervals: From 0 ft. to 107 ft., From ft. to ft., From 107 ft. to 123 ft.
 What is the nearest source of possible contamination:
 1 Septic tank 4 Lateral lines 7 Pit privy 10 Livestock pens 14 Abandoned water well
 2 Sewer lines 5 Cess pool 8 Sewage lagoon 11 Fuel storage 15 Oil well/Gas well
 3 Watertight sewer lines 6 Seepage pit 9 Feedyard 12 Fertilizer storage 16 Other (specify below)
 13 Insecticide storage None known
 Direction from well? How many feet?

FROM	TO	LITHOLOGIC LOG	FROM	TO	PLUGGING INTERVALS
0	3	Topsoil	144	146	Clay, brown
3	24	Clay, brown, soft	146	148	Shale, red
24	31	Clay, white			
31	32	Sand, silty			
32	34	Caliche with sand, fine			
34	47	Sand, fine			
47	57	Sand, medium, coarse			
57	64	Sand and gravel, fine, medium			
64	69	Sand and gravel, medium, coarse			
69	89	Clay, white			
89	118	Sand and gravel, medium, coarse			
118	120	Clay, brown			
120	136	Sand and gravel, medium, coarse			
136	139	Clay, brown with sand mixed			
139	144	Clay, brown with sand and gravel mixed			

7 CONTRACTOR'S OR LANDOWNER'S CERTIFICATION: This water well was (1) constructed, (2) reconstructed, or (3) plugged under my jurisdiction and was completed on (mo/day/year) 5-4-99 and this record is true to the best of my knowledge and belief Kansas Water Well Contractor's License No. 185 This Water Well Record was completed on (mo/day/yr) 5-5-99 under the business name of Clarke Well & Equipment, Inc. by (signature) *Clark W. Clarke*

OFFICE USE ONLY
T
R
EW
SEC.