


1 LOCATION OF WATER WELL: Pratt	FRACTION SW 1/4 SW 1/4 SW 1/4	Section Number 36	Township Number T 26 S	Range Number R 11W E/W
---	---	-----------------------------	----------------------------------	----------------------------------

Distance and direction from nearest town or city street address of well if located within city?

2 miles South and 4 miles East of Preston, Kansas

WATER WELL OWNER: TRINKLE, Don	Board of Agriculture, Division of Water Resource
RR#, ST. ADDRESS, BOX #: 70030 NE 110 Ave	Application Number: 43249
CITY, STATE, ZIP CODE: Preston, Kansas 67567	

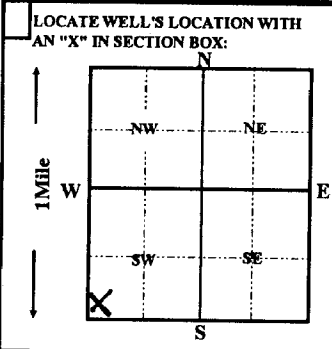

4 DEPTH OF COMPLETED WELL 72 ft.	ELEVATION:
Depth(s) groundwater Encountered 1 ft.	2 ft.
WELL'S STATIC WATER LEVEL 27 FT. BELOW LAND SURFACE MEASURED ON 05/05/1999	
Pump test data: Well water was ft. after hours pumping gpm	
Est. Yield 700 gpm: Well water was ft. after hours pumping gpm	
Bore Hole Diameter 30 in. to 115 ft. and in. to ft.	
WELL WATER TO BE USED AS:	
1 Domestic	3 Feedlot
2 Irrigation	4 Industrial
6 Oil field water supply	7 Lawn and garden only
8 Air conditioning	9 Dewatering
11 Injection well	12 Other (Specify below)
Was a chemical/bacteriological sample submitted to Department? Yes <input type="checkbox"/> No <input checked="" type="checkbox"/> ; If yes, mo/day/yr sample was submitted	
Water Well Disinfected? Yes <input checked="" type="checkbox"/> No <input type="checkbox"/>	

5 TYPE OF CASING USED:	5 Wrought iron	8 Concrete tile	CASING JOINTS:
1 Steel	3 RMP (SR)	6 Asbestos-Cement	Glued <input checked="" type="checkbox"/> Clamped
2 PVC	4 ABS	7 Fiberglass	Welded
Blank casing Diameter 16 in. to 52 ft., Dia	in. to ft. , Dia	9 Other (Specify below)	Threaded
Casing height above land surface 12 in., weight 19.75 lbs. / ft.	Wall thickness or gauge No. .616		
TYPE OF SCREEN OR PERFORATION MATERIAL:			
1 Steel	3 Stainless Steel	5 Fiberglass	8 RMP (SR)
2 Brass	4 Galvanized steel	6 Concrete tile	9 ABS
SCREEN OR PERFORATION OPENING ARE:			
1 Continous slot	3 Mill slot	5 Gauzed wrapped	8 Saw cut
2 Louvered shutter	4 Key punched	6 Wire wrapped	9 Drilled holes
SCREEN-PERFORATION INTERVALS:			
from 52 ft. to 72 ft., From	ft. to ft.	ft., From	ft. to ft.
GRAVEL PACK INTERVALS:	from 20 ft. to 72 ft., From	ft., From	ft. to ft.

6 GROUT MATERIAL: 1 Neat cement	2 Cement grout	3 Bentonite	4 Other cement & hole plug
Grout Intervals: From 0 ft. to 20 ft. From	ft. From	ft. to	ft. From
What is the nearest source of possible contamination:			
1 Septic tank	4 Lateral lines	7 Pit privy	10 Livestock pens
2 Sewer lines	5 Cess pool	8 Sewage lagoon	11 Fuel storage
3 Watertight sewer lines	6 Seepage pit	9 Feedyard	12 Fertilizer storage
			13 Insecticide storage
			None Apparent

FROM		TO		LITHOLOGIC LOG	FROM		TO		PLUGGING INTERVALS
0	2			sandy soil					
2	4			very fine sand					
4	10			brown clay					
10	33			fine to coarse sand & fine to coarse gravel with clay streaks					
33	38			tan and white clay					
38	49			fine to coarse sand and medium gravel					
49	51			tan clay					
51	72			fine to coarse sand and fine to coarse gravel-loose					
72	73			tan clay					

7 CONTRACTOR'S OR LANDOWNER'S CERTIFICATION: This water well was (1) constructed, (2) reconstructed, or (3) plugged under my jurisdiction and was completed on (mo/day/year) 05/05/1999 and this record is true to the best of my knowledge and belief. Kansas Water Well Contractor's License No. 236 This Water Well Record was completed on (mo/day/yr) 05/10/99	
Under the business name of Harp Well & Pump Service, Inc by (signature)	<i>Todd S. Harp</i>