


1 LOCATION OF WATER WELL: <b>Pratt</b>	FRACTION <b>center of</b> 1/4 1/4 SW 1/4	Section Number <b>15</b>	Township Number <b>T 26 S</b>	Range Number <b>R 11W E/W</b>
---	--	-----------------------------	----------------------------------	----------------------------------

Distance and direction from nearest town or city street address of well if located within city?

**2 mile East, 1 1/4 miles North of Preston, Kansas**

WATER WELL OWNER: <b>BROWN, Stan</b>	Board of Agriculture, Division of Water Resource
RR#, ST. ADDRESS, BOX #: <b>130177 NE 70 Street</b>	Application Number: <b>43192</b>
CITY, STATE, ZIP CODE: <b>Preston, Kansas 67569</b>	

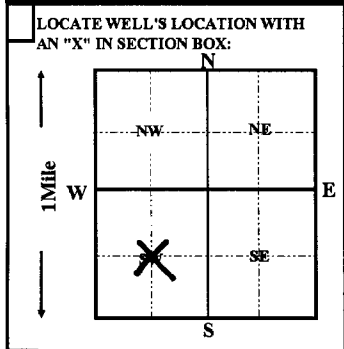

WELL'S STATIC WATER LEVEL <b>27</b> FT. BELOW LAND SURFACE MEASURED ON <b>05/05/1999</b>	Pump test data:		
Well water was <b>ft. after</b> hours pumping <b>gpm</b>	Well water was <b>ft. after</b> hours pumping <b>gpm</b>		
Est. Yield <b>900</b> gpm:	Bore Hole Diameter <b>30</b> in. to <b>115</b> ft. and in. to ft.		
WELL WATER TO BE USED AS:	5 Public water supply 8 Air conditioning 11 Injection well		
1 Domestic 3 Feedlot 6 Oil field water supply 9 Dewatering 12 Other (Specify below)	2 Irrigation 4 Industrial 7 Lawn and garden only 10 Monitoring well		
Was a chemical/bacteriological sample submitted to Department? Yes <input type="checkbox"/> No <input checked="" type="checkbox"/> ; If yes, mo/day/yr sample was submitted	Water Well Disinfected? Yes <input checked="" type="checkbox"/> No <input type="checkbox"/>		

5 TYPE OF CASING USED:	5 Wrought iron	8 Concrete tile	CASING JOINTS: Glued <input checked="" type="checkbox"/> Clamped
1 Steel 3 RMP (SR)	6 Asbestos-Cement	9 Other (Specify below)	Welded
2 PVC 4 ABS	7 Fiberglass		Threaded
Blank casing Diameter <b>16</b> in. to <b>75</b> ft., Dia in. to ft.	Weight <b>19.75</b> lbs. / ft.	Wall thickness or gauge No. <b>.616</b>	
Casing height above land surface <b>12</b> in.			
TYPE OF SCREEN OR PERFORATION MATERIAL:	5 Fiberglass	8 RMP (SR)	11 other (specify)
1 Steel 3 Stainless Steel	6 Concrete tile	9 ABS	12 None used (open hole)
2 Brass 4 Galvanized steel			
SCREEN OR PERFORATION OPENING ARE:	5 Gauzed wrapped	8 Saw cut	11 None (open hole)
1 Continous slot 3 Mill slot	6 Wire wrapped	9 Drilled holes	
2 Louvered shutter 4 Key punched	7 Torch cut	10 Other (specify)	
SCREEN-PERFORATION INTERVALS: from <b>75</b> ft. to <b>115</b> ft., From ft. to ft.			
GRAVEL PACK INTERVALS: from <b>20</b> ft. to <b>115</b> ft., From ft. to ft.			

6 GROUT MATERIAL: 1 Neat cement	2 Cement grout	3 Bentonite	4 Other <b>cement and hole plug</b>
Grout Intervals: From <b>0</b> ft. to <b>20</b> ft. From ft. to ft.			
What is the nearest source of possible contamination:	10 Livestock pens	11 Fuel storage	12 Fertilizer storage
1 Septic tank 4 Lateral lines 7 Pit privy	11 Fuel storage	12 Fertilizer storage	13 Insecticide storage
2 Sewer lines 5 Cess pool 8 Sewage lagoon	12 Fertilizer storage	13 Insecticide storage	14 Abandon water well
3 Watertight sewer lines 6 Seepage pit 9 Feedyard	13 Insecticide storage	14 Abandon water well	15 Oil well/Gas well
			16 Other (specify below)
			<b>None Apparent</b>

Direction from well?		How many feet?	
FROM	TO	FROM	TO
0	2		
2	4		
4	16		
16	20		
20	34		
34	44		
44	46		
46	59		
59	61		
61	65		
65	78		
78	115		

7 CONTRACTOR'S OR LANDOWNER'S CERTIFICATION: This water well was (1) constructed, (2) reconstructed, or (3) plugged under my jurisdiction and was completed on (mo/day/year) <b>05/05/1999</b> and this record is true to the best of my knowledge and belief. Kansas Water Well Contractor's License No. <b>236</b> This Water Well Record was completed on (mo/day/yr) <b>05/10/99</b>	
Under the business name of <b>Harp Well &amp; Pump Service, Inc.</b> by (signature)	<i>Todd S. Harp</i>