


1 LOCATION OF WATER WELL: Fraction 1/4 NC 1/4 NW 1/4 Section Number 9 Township Number T 26 S Range Number R 11 E W

County: Pratt

Distance and direction from nearest town or city street address of well if located within city?
 Approximately 2 3/4 miles north and 1 1/4 miles east of Preston

2 WATER WELL OWNER: Norman Hildebrand
 RR#, St. Address, Box # : Route 1 - Box 114 Board of Agriculture, Division of Water Resources
 City, State, ZIP Code : Stafford, KS 67578 Application Number: 40,166

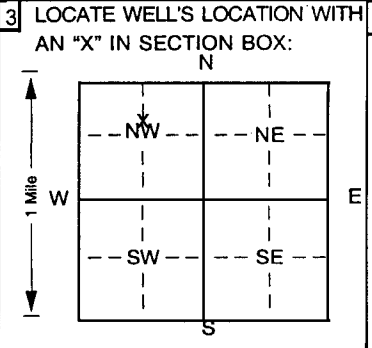

4 DEPTH OF COMPLETED WELL 71 ft. ELEVATION: unknown

Depth(s) Groundwater Encountered 1 _____ ft. 2 _____ ft. 3 _____ ft.

WELL'S STATIC WATER LEVEL 40 ft. below land surface measured on mo/day/yr 10-23-00

Pump test data: Well water was not checked ft. after _____ hours pumping _____ gpm

Est. Yield unknown gpm: Well water was _____ ft. after _____ hours pumping _____ gpm

Bore Hole Diameter 24 in. to 69 ft., and _____ in. to _____ ft.

WELL WATER TO BE USED AS: 5 Public water supply 8 Air conditioning 11 Injection well

1 Domestic 3 Feedlot 6 Oil field water supply 9 Dewatering 12 Other (specify below)

2 Irrigation 4 Industrial 7 Domestic (lawn & garden) 10 Monitoring well

Was a chemical/bacteriological sample submitted to Department? Yes _____ No If yes, mo/day/yrs sample was submitted _____

Water Well Disinfected? Yes _____ No

5 TYPE OF BLANK CASING USED:

1 Steel 3 RMP (SR) 5 Wrought iron 8 Concrete tile CASING JOINTS: Glued Clamped _____

2 PVC 4 ABS 6 Asbestos-Cement 9 Other (specify below) Welded _____

7 Fiberglass _____ Threaded _____

Blank casing diameter 10 in. to 53 ft., Dia _____ in. to _____ ft.

Casing height above land surface 24 in., weight _____ 7.80 lbs./ft. Wall thickness or gauge No .365

TYPE OF SCREEN OR PERFORATION MATERIAL:

1 Steel 3 Stainless steel 5 Fiberglass 8 RMP (SR) 10 Asbestos-cement

2 Brass 4 Galvanized steel 6 Concrete tile 9 ABS 11 Other (specify) _____

12 None used (open hole)

SCREEN OR PERFORATION OPENINGS ARE:

5 Gauzed wrapped 8 Saw cut 11 None (open hole)

1 Continuous slot 3 Mill slot 6 Wire wrapped 9 Drilled holes

2 Louvered shutter 4 Key punched 7 Torch cut 10 Other (specify) Bridge Slot _____ ft.

SCREEN-PERFORATED INTERVALS: From 53 ft. to 69 ft., From _____ ft. to _____ ft.

GRAVEL PACK INTERVALS: From 45 ft. to 69 ft., From _____ ft. to _____ ft.

6 GROUT MATERIAL: 1 Neat cement 2 Cement grout 3 Bentonite 4 Other Road Sand

Grout Intervals: From 0 ft. to 22 ft., From _____ ft. to _____ ft., From 22 ft. to 45 ft.

What is the nearest source of possible contamination:

1 Septic tank 4 Lateral lines 7 Pit privy 10 Livestock pens 14 Abandoned water well

2 Sewer lines 5 Cess pool 8 Sewage lagoon 11 Fuel storage 15 Oil well/Gas well

3 Watertight sewer lines 6 Seepage pit 9 Feedyard 12 Fertilizer storage 16 Other (specify below)

13 Insecticide storage _____ None known _____

Direction from well? _____ How many feet? _____

FROM	TO	LITHOLOGIC LOG	FROM	TO	PLUGGING INTERVALS
0	3	Topsoil			
3	25	Clay, brown			
25	29	Clay, white			
29	31	Sand, fine			
31	33	Cemented Sand			
33	45	Sand, fine			
45	57	Sand and gravel, fine, medium			
57	64	Sand and gravel, fine, medium			
64	69	Sand and gravel, fine, medium, coarse			

7 CONTRACTOR'S OR LANDOWNER'S CERTIFICATION: This water well was (1) constructed, (2) reconstructed, or (3) plugged under my jurisdiction and was completed on (mo/day/year) 10-23-00 and this record is true to the best of my knowledge and belief. Kansas Water Well Contractor's License No 185 This Water Well Record was completed on (mo/day/yr) 10-31-00 under the business name of Clarke Well & Equipment, Inc. by (signature) [Signature]