


1 LOCATION OF WATER WELL: Pratt	FRACTION SW 1/4 NE 1/4 SW 1/4	Section Number 35	Township Number T 26 S	Range Number R 11W E/W
---	---	-----------------------------	----------------------------------	----------------------------------

Distance and direction from nearest town or city street address of well if located within city?
1,320' N. & 3,685' W. of SE corner of section 35

WATER WELL OWNER: HUFF, Dennis	Board of Agriculture, Division of Water Resource
RR#, ST. ADDRESS, BOX #: 50506 Northeast 130th Ave	Application Number: 43,587
CITY, STATE, ZIP CODE: Preston, Kansas	

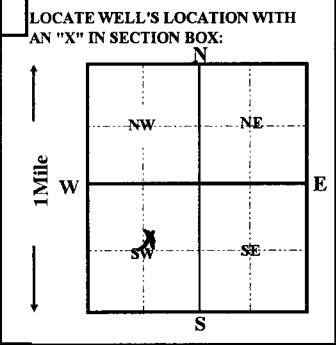

4 DEPTH OF COMPLETED WELL **75** ft. ELEVATION:

Depth(s) groundwater Encountered **1** ft. **2** ft. **3** ft.

WELL'S STATIC WATER LEVEL **17** FT. BELOW LAND SURFACE MEASURED ON **05/23/2001**

Pump test data: Well water was **ft. after** hours pumping **gpm**

Est. Yield **gpm:** Well water was **ft. after** hours pumping **gpm**

Bore Hole Diameter **36** in. to **75** ft. and **in.** to **ft.**

WELL WATER TO BE USED AS:

1 Domestic	3 Feedlot	6 Oil field water supply	9 Dewatering	12 Other (Specify below)
2 Irrigation	4 Industrial	7 Lawn and garden only	10 Monitoring well	

Was a chemical/bacteriological sample submitted to Department? Yes No ; If yes, mo/day/yr sample was submitted

Water Well Disinfected? Yes No

5 TYPE OF CASING USED:

1 Steel	3 RMP (SR)	5 Wrought iron	8 Concrete tile	CASING JOINTS: Glued <input checked="" type="checkbox"/> Clamped
2 PVC	4 ABS	6 Asbestos-Cement	9 Other (Specify below)	Welded
		7 Fiberglass	SDR-26	Threaded

Blank casing Diameter **16** in. to **39** ft., Dia **in.** to **ft.**

Casing height above land surface **48** in., weight **19.750** lbs. / ft. Wall thickness or gauge No. **.616**

TYPE OF SCREEN OR PERFORATION MATERIAL:

1 Steel	3 Stainless Steel	5 Fiberglass	8 RMP (SR)	10 Asbestos-cement
2 Brass	4 Galvanized steel	6 Concrete tile	9 ABS	11 other (specify)
				12 None used (open hole)

SCREEN OR PERFORATION OPENING ARE:

1 Continous slot	3 Mill slot	5 Gauzed wrapped	8 Saw cut	11 None (open hole)
2 Louvered shutter	4 Key punched	6 Wire wrapped	9 Drilled holes	
		7 Torch cut	10 Other (specify)	

SCREEN-PERFORATION INTERVALS: from **39** ft. to **75** ft., From **ft.** to **ft.**

GRAVEL PACK INTERVALS: from **27** ft. to **75** ft., From **ft.** to **ft.**

6 GROUT MATERIAL: 1 Neat cement 2 Cement grout 3 Bentonite 4 Other **bentonite hole plug**

Grout Intervals: From **0** ft. to **20** ft. From **ft.** to **ft.** From **20** ft. to **27** ft.

What is the nearest source of possible contamination:

1 Septic tank	4 Lateral lines	7 Pit privy	10 Livestock pens	14 Abandon water well
2 Sewer lines	5 Cess pool	8 Sewage lagoon	11 Fuel storage	15 Oil well/Gas well
3 Watertight sewer lines	6 Seepage pit	9 Feedyard	12 Fertilizer storage	16 Other (specify below)
			13 Insecticide storage	None Apparent

Direction from well?			How many feet?		
FROM	TO	LITHOLOGIC LOG	FROM	TO	PLUGGING INTERVALS
0	3	sandy soil			
3	8	tan & white clay			
8	10	fine sand			
10	20	tan & white clay			
20	28	sandy tan clay			
28	58	fine to coarse sand to fine gravel			
58	72	fine to coarse sand to medium gravel			
72	75	red shale			

7 CONTRACTOR'S OR LANDOWNER'S CERTIFICATION: This water well was (1) constructed, (2) reconstructed, or (3) plugged under my jurisdiction and was completed on (mo/day/year) **05/23/01** and this record is true to the best of my knowledge and belief. Kansas Water Well Contractor's License No. **236** This Water Well Record was completed on (mo/day/yr) **06/30/01**

Under the business name of **Harp Well & Pump Service, Inc.** by (signature) **Todd S. Harp**