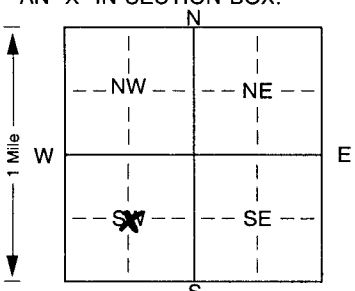


1 LOCATION OF WATER WELL: Fraction W 1/2 E 1/2 SW 1/4 Section Number 35 Township Number T 26 S R 11 Range Number EW  
 County: Pratt

Distance and direction from nearest town or city street address of well if located within city?  
From Preston, KS: 2 miles South + 4 3/4 miles West

2 WATER WELL OWNER: Dennis Huff  
 RR#, St. Address, Box #: 50506 NE 130th Ave Board of Agriculture, Division of Water Resources  
 City, State, ZIP Code: Preston, KS 67583 Application Number: 43589

3 LOCATE WELL'S LOCATION WITH AN "X" IN SECTION BOX:  
  
 4 DEPTH OF COMPLETED WELL: 72 ft. ELEVATION: .....  
 Depth(s) Groundwater Encountered 1. 19 ft. 2. .... ft. 3. .... ft.  
 WELL'S STATIC WATER LEVEL: 19 ft. below land surface measured on mo/day/yr 12-24-02  
 Pump test data: Well water was ..... ft. after ..... hours pumping ..... gpm  
 Est. Yield 400 gpm: Well water was ..... ft. after ..... hours pumping ..... gpm  
 Bore Hole Diameter: 30 in. to 72 ft., and ..... in. to ..... ft.  
 WELL WATER TO BE USED AS:  
 5 Public water supply 8 Air conditioning 11 Injection well  
 1 Domestic 3 Feedlot 6 Oil field water supply 9 Dewatering 12 Other (Specify below)  
 0 Irrigation 4 Industrial 7 Domestic (lawn & garden) 10 Monitoring well .....  
 Was a chemical/bacteriological sample submitted to Department? Yes. .... No. X; If yes, mo/day/yr sample was submitted  
 Water Well Disinfected? Yes X No

5 TYPE OF BLANK CASING USED:  
 1 Steel 3 RMP (SR) 5 Wrought iron 8 Concrete tile CASING JOINTS: Glued. X Clamped. ....  
 2 PVC 4 ABS 6 Asbestos-Cement 9 Other (specify below) Welded .....  
 7 Fiberglass Threaded .....  
 Blank casing diameter: 16 in. to 52 ft., Dia ..... in. to ..... ft., Dia ..... in. to ..... ft.  
 Casing height above land surface: 12 in., weight 16 lbs./ft. Wall thickness or gauge No. 1/2"  
 TYPE OF SCREEN OR PERFORATION MATERIAL:  
 1 Steel 3 Stainless steel 5 Fiberglass 8 RMP (SR) 10 Asbestos-cement  
 2 Brass 4 Galvanized steel 6 Concrete tile 9 ABS 11 Other (specify) .....  
 12 None used (open hole)  
 SCREEN OR PERFORATION OPENINGS ARE:  
 1 Continuous slot 2 Mill slot 5 Gauzed wrapped 8 Saw cut 11 None (open hole)  
 2 Louvered shutter 4 Key punched 6 Wire wrapped 9 Drilled holes  
 7 Torch cut 10 Other (specify) ..... ft.  
 SCREEN-PERFORATED INTERVALS: From 52 ft. to 72 ft., From ..... ft. to ..... ft.  
 From ..... ft. to ..... ft., From ..... ft. to ..... ft.  
 GRAVEL PACK INTERVALS: From 20 ft. to 72 ft., From ..... ft. to ..... ft.  
 From ..... ft. to ..... ft., From ..... ft. to ..... ft.

6 GROUT MATERIAL: 1 Neat cement 2 Cement grout 3 Bentonite 4 Other .....  
 Grout Intervals: From 3 ft. to 20 ft., From ..... ft. to ..... ft., From ..... ft. to ..... ft.  
 What is the nearest source of possible contamination:  
 1 Septic tank 4 Lateral lines 7 Pit privy 10 Livestock pens 14 Abandoned water well  
 2 Sewer lines 5 Cess pool 8 Sewage lagoon 11 Fuel storage 15 Oil well/Gas well  
 3 Watertight sewer lines 6 Seepage pit 9 Feedyard 12 Fertilizer storage 16 Other (specify below)  
Irrigation Well  
 Direction from well? East How many feet? 300

FROM	TO	LITHOLOGIC LOG	FROM	TO	PLUGGING INTERVALS
0	3	Sandy Soil			
3	8	Tan Clay			
8	10	Fine Sand			
10	20	Tan + White Clay			
20	29	Sandy Tan Clay			
29	59	Fine to Coarse Sand to Fine Gravel			
59	72	Fine to Coarse Sand to Medium Gravel			
72		Red shale			

7 CONTRACTOR'S OR LANDOWNER'S CERTIFICATION: This water well was (1) constructed, (2) reconstructed, or (3) plugged under my jurisdiction and was completed on (mo/day/year) 12-23-02 and this record is true to the best of my knowledge and belief. Kansas Water Well Contractor's Licence No. 238 This Water Well Record was completed on (mo/day/yr) 1-7-03 under the business name of Wendiger Irrigation by (signature) Art Wendiger