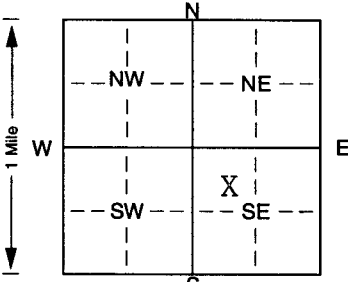


1 LOCATION OF WATER WELL: Fraction C 1/4 NW 1/4 SE 1/4 Section Number 26 Township Number T 26 S Range Number R 11 E  
 County: Pratt

Distance and direction from nearest town or city street address of well if located within city?  
3 1/2 East, 1/2 South of Preston

2 WATER WELL OWNER: L.D. Drilling  
 RR#, St. Address, Box # : 7 S.W. 26th Ave Board of Agriculture, Division of Water Resources  
 City, State, ZIP Code : Great Bend, Ks. 67530 Application Number: 20030047

3 LOCATE WELL'S LOCATION WITH AN "X" IN SECTION BOX:  
  
 4 DEPTH OF COMPLETED WELL: 84 ft. ELEVATION:  
 Depth(s) Groundwater Encountered 1. .... ft. 2. .... ft. 3. .... ft.  
 WELL'S STATIC WATER LEVEL ... 23 ft. below land surface measured on mo/day/yr 3-17-03  
 Pump test data: Well water was .... ft. after .... hours pumping .... gpm  
 Est. Yield ... N/A gpm: Well water was .... ft. after .... hours pumping .... gpm  
 Bore Hole Diameter. .... 9 in. to .... 8.4 ft., and .... in. to .... ft.  
 WELL WATER TO BE USED AS: 5 Public water supply 8 Air conditioning 11 Injection well  
 1 Domestic 3 Feedlot 6 Oil field water supply 9 Dewatering 12 Other (Specify below)  
 2 Irrigation 4 Industrial 7 Domestic (lawn & garden) 10 Monitoring well  
 Was a chemical/bacteriological sample submitted to Department? Yes. .... No. X ...; If yes, mo/day/yr sample was submitted  
 Water Well Disinfected? Yes HTH No

5 TYPE OF BLANK CASING USED:  
 1 Steel 3 RMP (SR) 6 Asbestos-Cement 9 Other (specify below) CASING JOINTS: Glued. ... X Clamped. ....  
 2 PVC 4 ABS 7 Fiberglass Threaded. ....  
 Blank casing diameter .... 5 in. to .... 6.4 ft., Dia .... in. to .... ft., Dia .... in. to .... ft.  
 Casing height above land surface. .... 24 in., weight SDR- 26 lbs./ft. Wall thickness or gauge No. ....  
 TYPE OF SCREEN OR PERFORATION MATERIAL:  
 1 Steel 3 Stainless steel 5 Fiberglass 7 PVC 10 Asbestos-cement  
 2 Brass 4 Galvanized steel 6 Concrete tile 9 ABS 11 Other (specify) ....  
 12 None used (open hole)  
 SCREEN OR PERFORATION OPENINGS ARE:  
 1 Continuous slot 3 Mill slot 5 Gauzed wrapped 8 Saw cut 11 None (open hole)  
 2 Louvered shutter 4 Key punched 6 Wire wrapped 9 Drilled holes  
 7 Torch cut 10 Other (specify) .... ft.  
 SCREEN-PERFORATED INTERVALS: From. .... 84 ft. to .... 64 ft., From .... ft. to .... ft.  
 From. .... ft. to .... ft., From .... ft. to .... ft.  
 GRAVEL PACK INTERVALS: From. .... 84 ft. to .... 20 ft., From .... ft. to .... ft.  
 From. .... ft. to .... ft., From .... ft. to .... ft.

6 GROUT MATERIAL: 1 Neat cement 2 Cement grout 3 Bentonite 4 Other .. hole plug  
 Grout intervals: From. .... 20 ft. to .... 0 ft., From .... ft. to .... ft., From .... ft. to .... ft.  
 What is the nearest source of possible contamination:  
 1 Septic tank 4 Lateral lines 7 Pit privy 10 Livestock pens 14 Abandoned water well  
 2 Sewer lines 5 Cess pool 8 Sewage lagoon 11 Fuel storage 15 Oil well/Gas well  
 3 Watertight sewer lines 6 Seepage pit 9 Feedyard 12 Fertilizer storage 16 Other (specify below)  
 13 Insecticide storage ... None  
 Direction from well? How many feet?

FROM	TO	LITHOLOGIC LOG	FROM	TO	PLUGGING INTERVALS
0	4	Sandy top soil			
4	12	Sandy clay & gravel			
12	19	Sand & gravel <del>med</del>			
19	27	Brown clay & ash			
27	29	Sand & gravel			
29	31	Tough yellow <del>clay</del> clay & white clay			
31	50	Sand & gravel <del>clean, med, loose</del>			
50	56	Sandy gray clay			
56	76	Sand & gravel med, loose with few small clay streaks			
76	77	Cemented sand			
77	84	Sand & gravel med, loose with small clay streaks			

7 CONTRACTOR'S OR LANDOWNER'S CERTIFICATION: This water well was (1) constructed, (2) reconstructed, or (3) plugged under my jurisdiction and was completed on (mo/day/year) ... 3-17-03 ... and this record is true to the best of my knowledge and belief. Kansas Water Well Contractor's Licence No. .... 134 .... This Water Well Record was completed on (mo/day/yr) ... 3-26-03 ... under the business name of Rosenkrantz- Bemis by (signature) [Signature]